

NO. STREET


DATE INST.

MAKE:

SIZE

125 ALLEN STREET

7-19-10

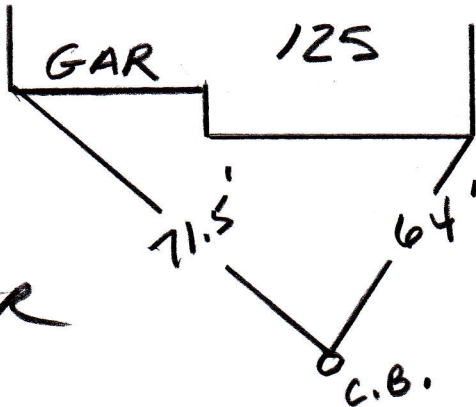

1" COPPER