



EAST LONGMEADOW DEPARTMENT OF PUBLIC WORKS

Job: Allen St water main from Parker St to ~~Parker~~ Fenway lane
Sheet No: 1 of _____
Calculated By: _____ Date 1-11-17
Scale: _____

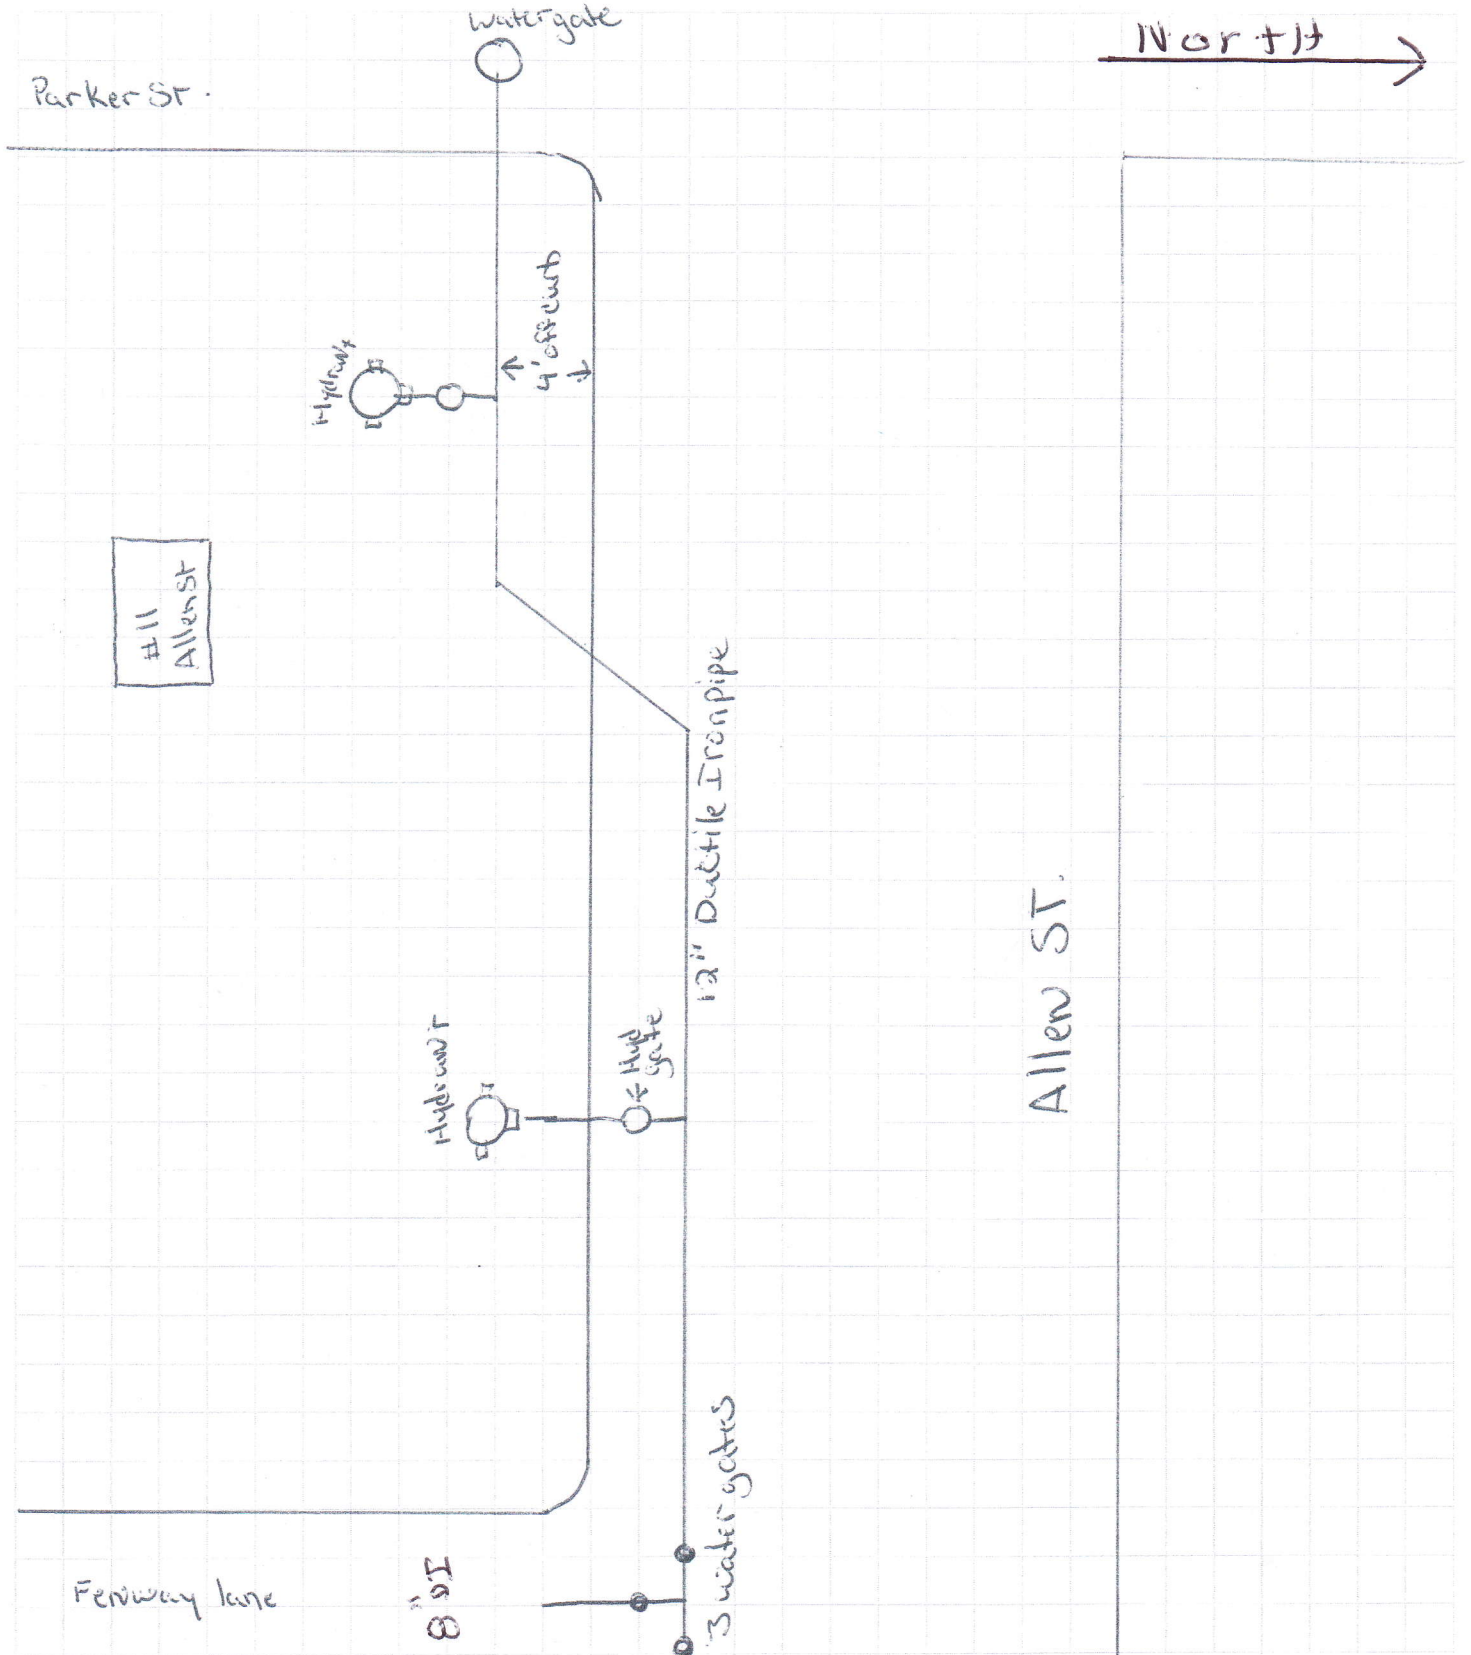

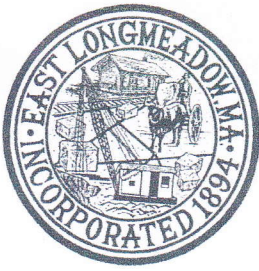


EAST LONGMEADOW DEPARTMENT OF PUBLIC WORKS


Job: Allen St Water main from Fenway Ln. to Porter Rd

Sheet No: 2 of _____

Calculated By: _____ Date 1-11-17

Scale: _____

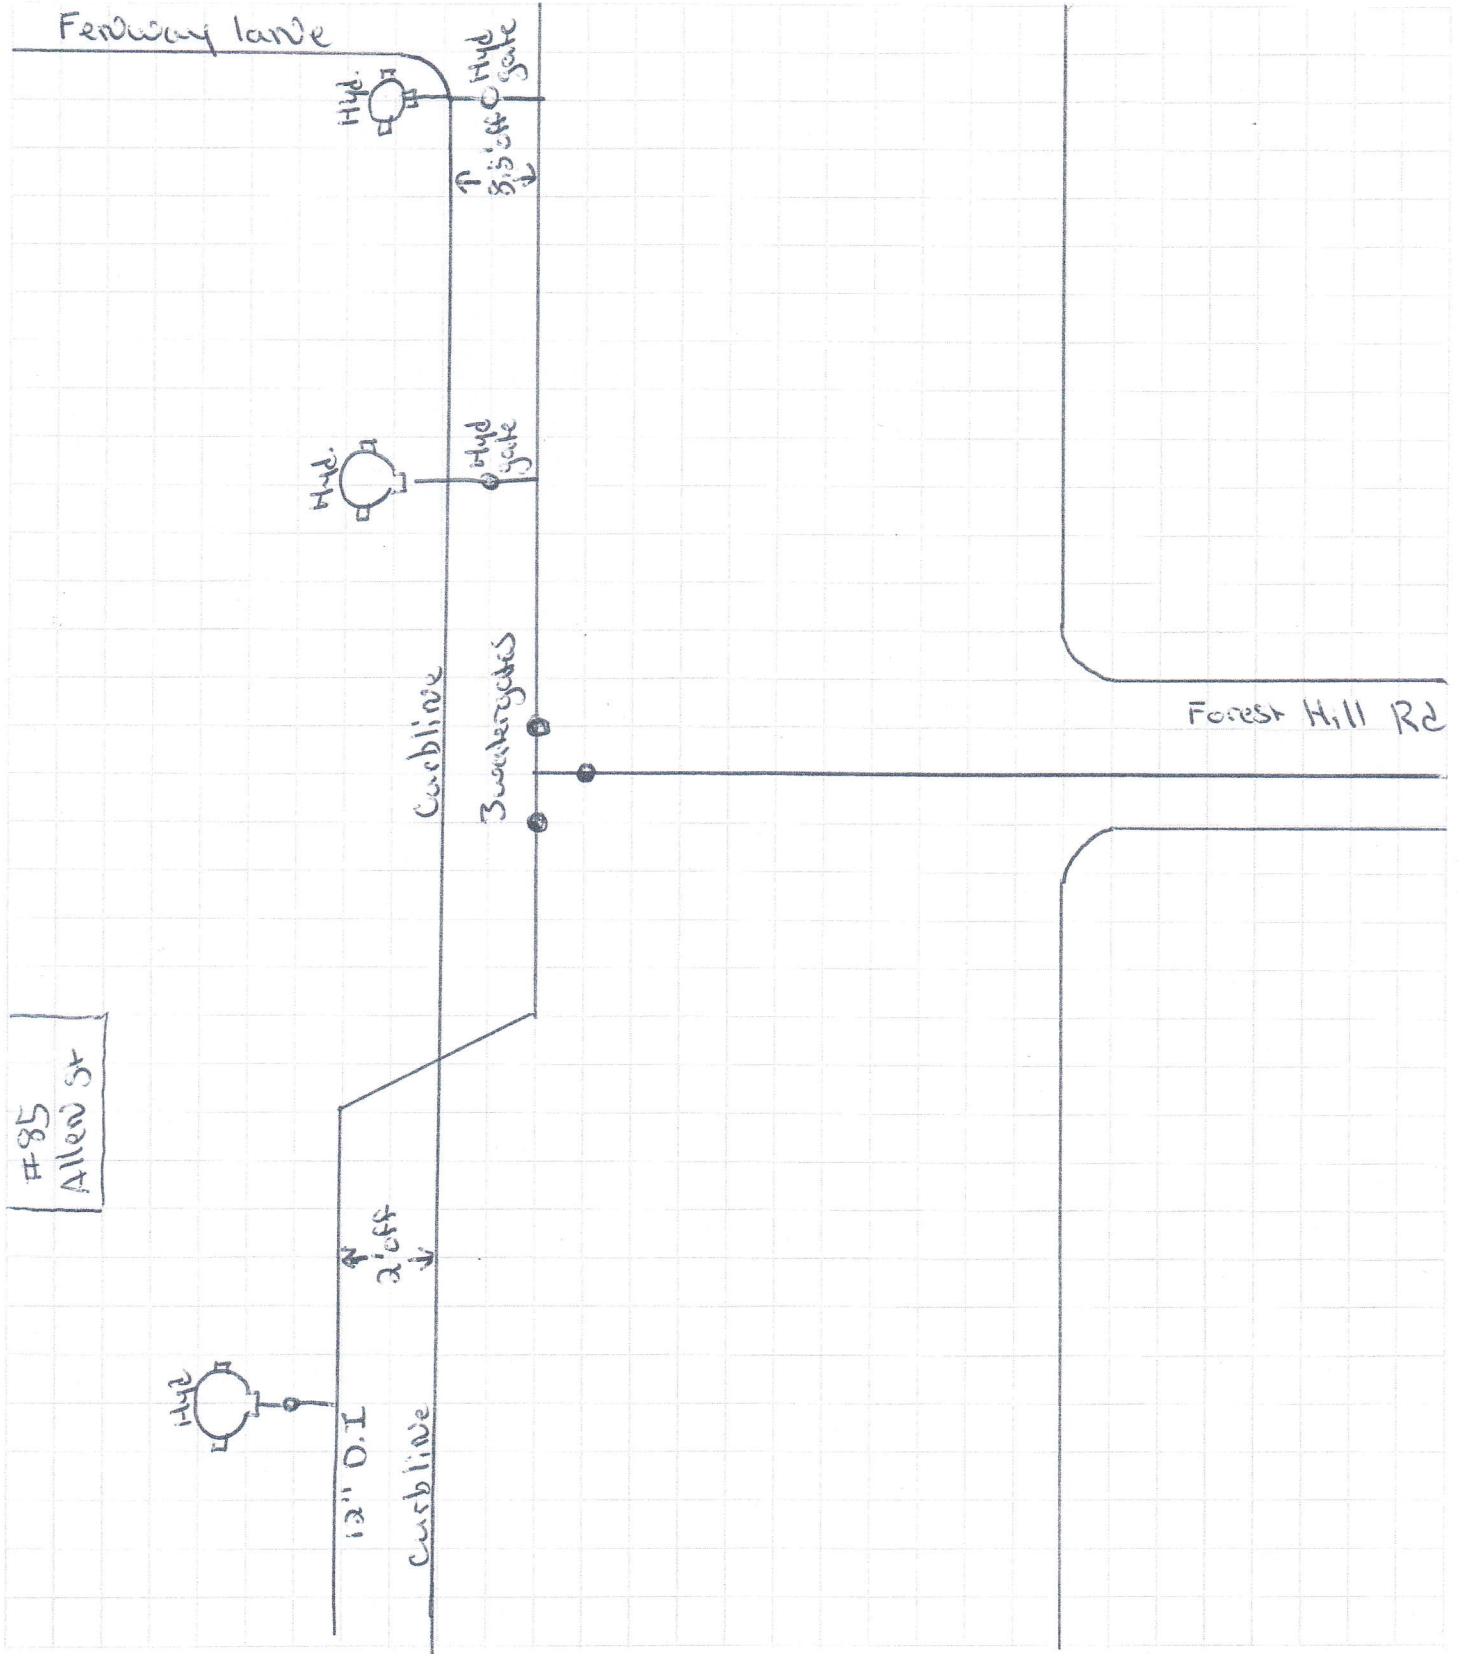

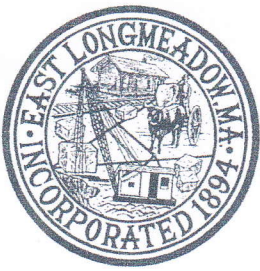

EAST LONGMEADOW DEPARTMENT OF PUBLIC WORKS

Job: Allen St water main from Fenway Ln to Parker Rd

Sheet No: 3 - Parker Rd Intersection of _____

Calculated By: _____ Date 1-11-17

Scale: _____

