


# ALPINE STREET - #51

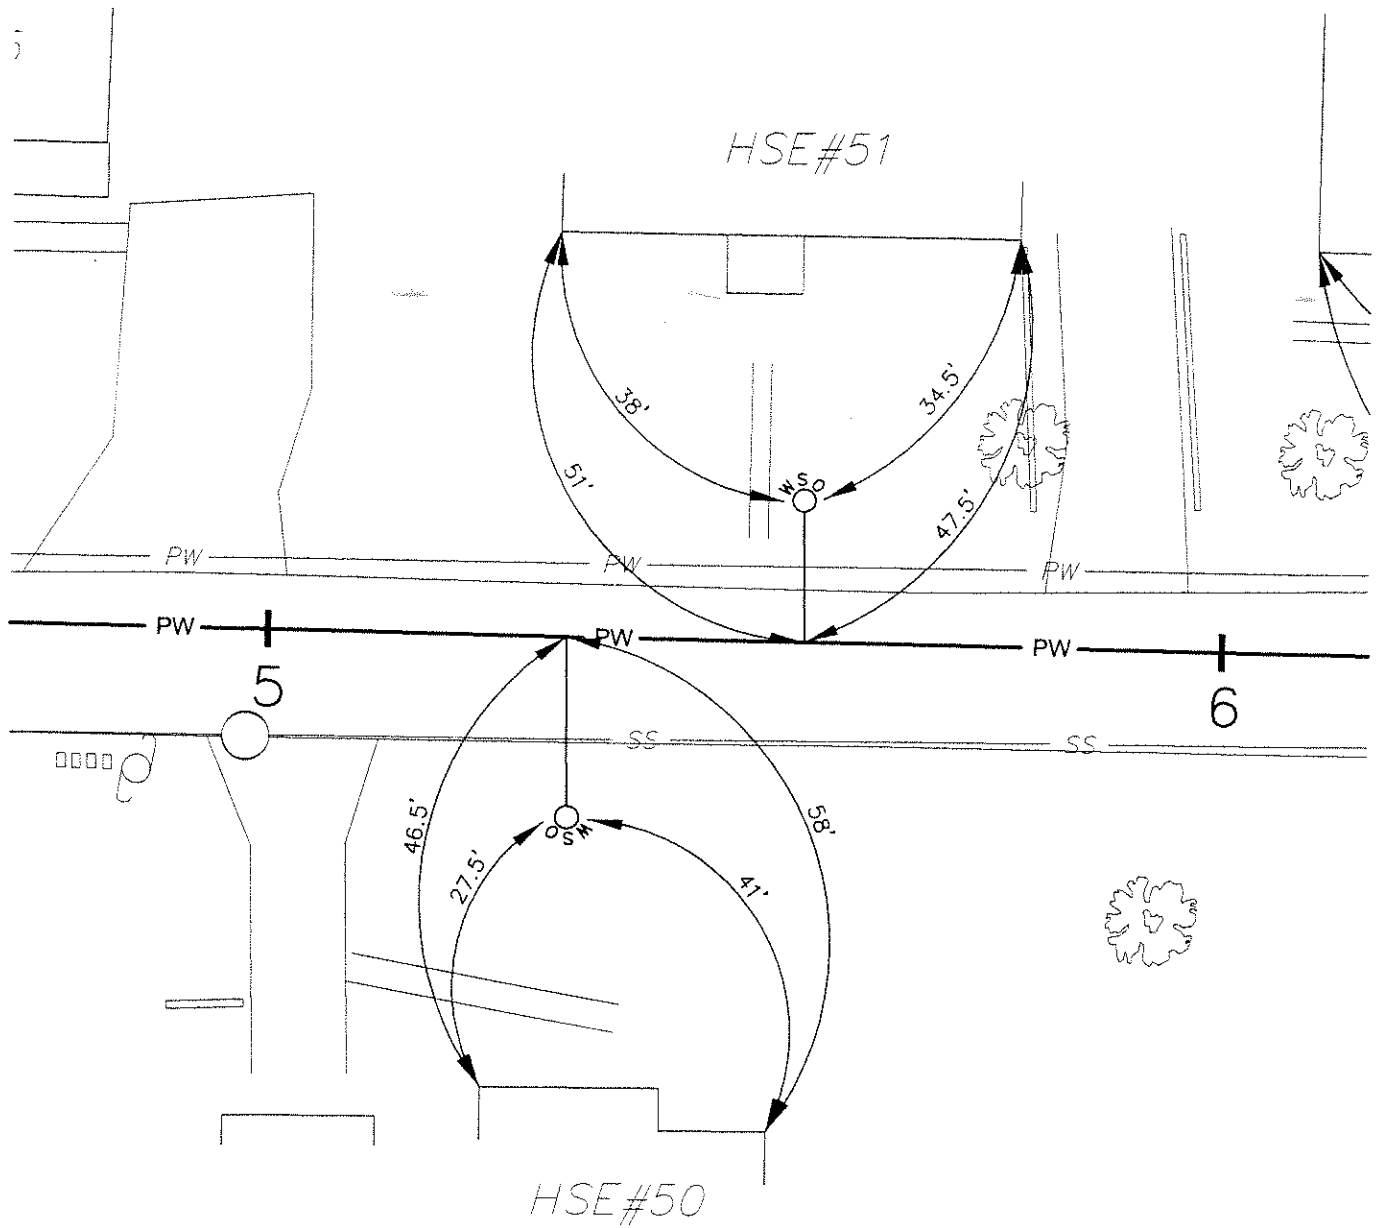

## HOUSE SERVICE INFORMATION:

DEPTH AT MAIN: 5.5'  
DEPTH AT PROPERTY LINE: 5'  
DATE INSTALLED: 11/15/04

PREPARED BY TIGHE & BOND