


51 ALPINE AVENUE

11-15-2004

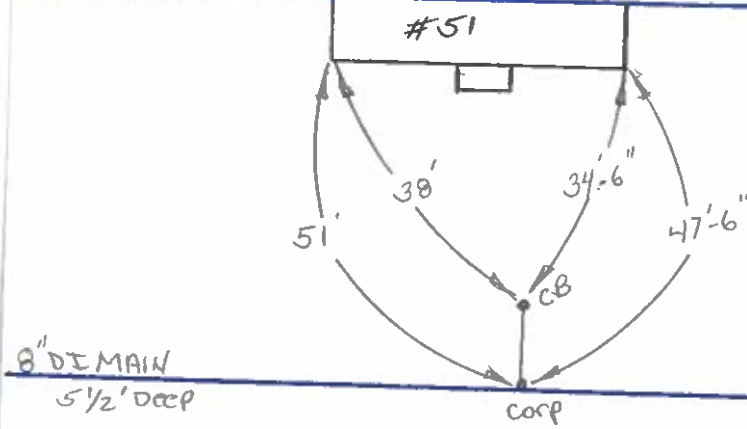

8" DI MAIN
5 1/2' DEEP