


ALPINE STREET - #67

HSE#67

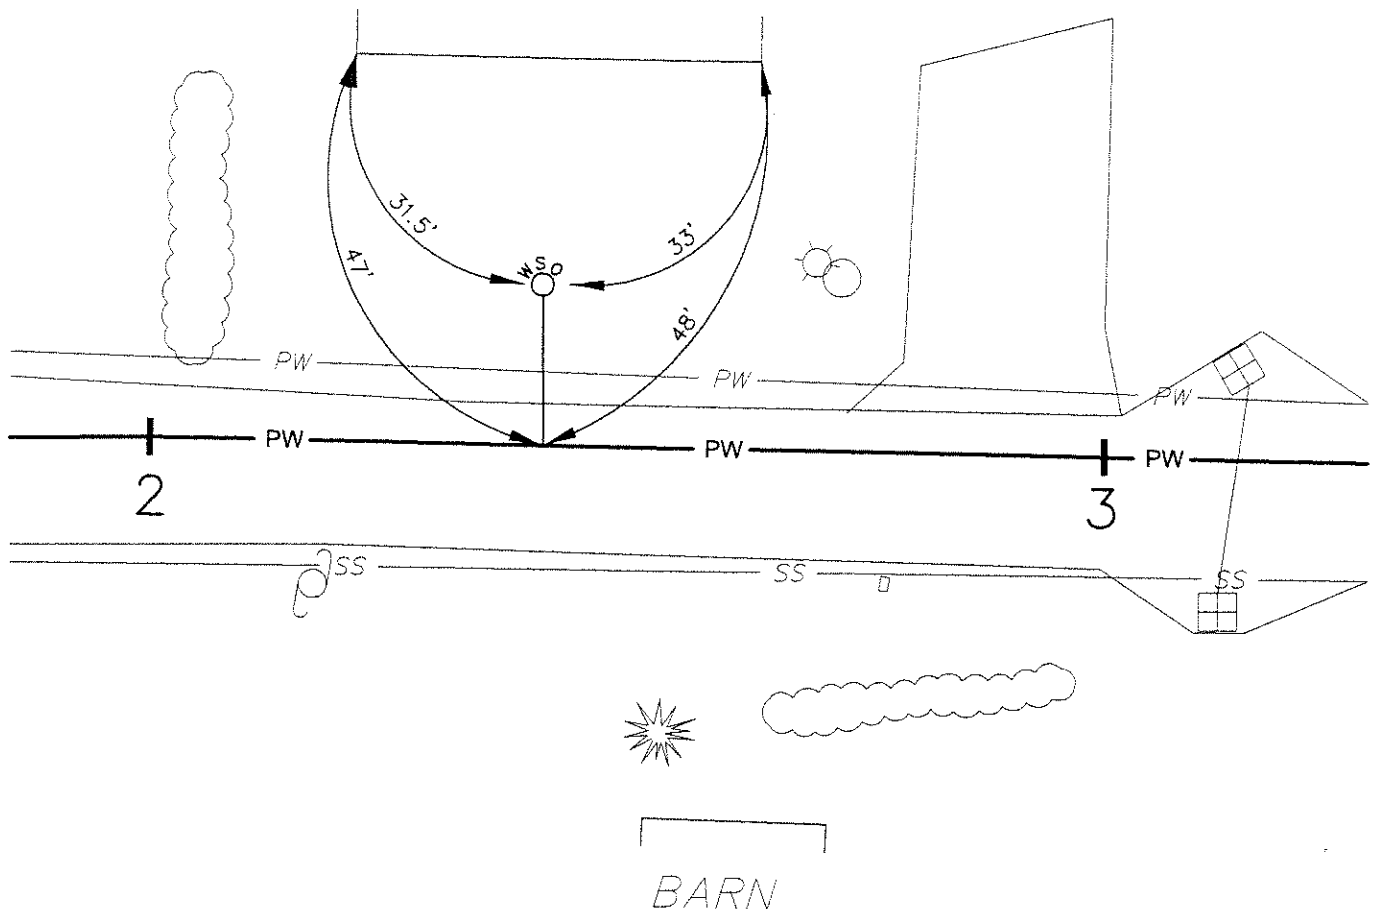

HOUSE SERVICE INFORMATION:

DEPTH AT MAIN: 5.5'
DEPTH AT PROPERTY LINE: 5'
DATE INSTALLED: 11/15/04

PREPARED BY TIGHE & BOND