


EAST LONGMEADOW DEPARTMENT OF PUBLIC WORKS

Job: 5 Amalfi	(water)
Sheet No:	of
Calculated By: Pope	Date 5-15-18
Scalé:	

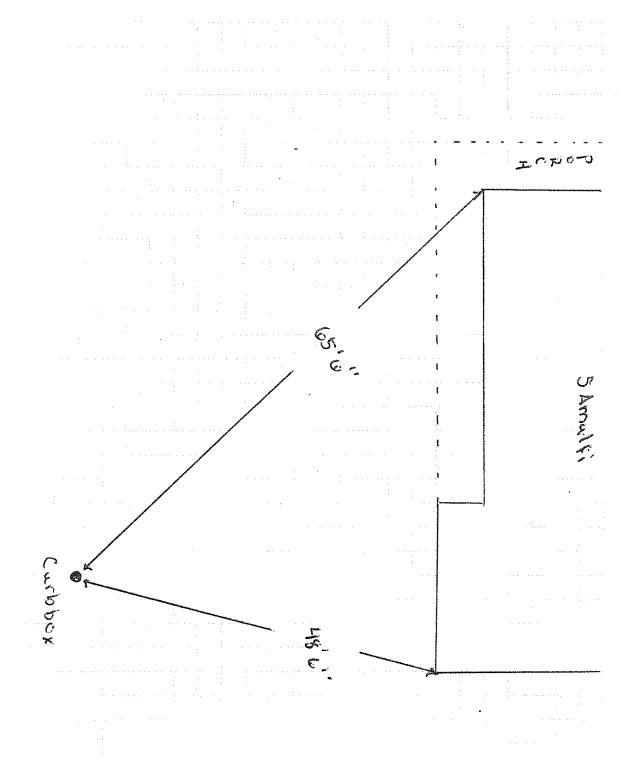

Description