

No. Street:


3 ANNA MARIE LA.

Date Inst: 8/1999 Make:

Size:

1"

(22' COPPER)

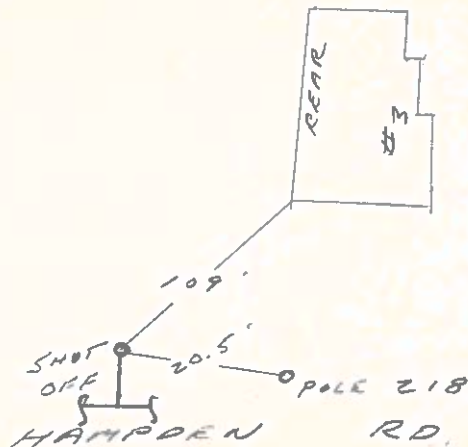

ANNA MARIE LA.