




EAST LONGMEADOW DEPARTMENT OF PUBLIC WORKS

Job: 41 Avery St / 8" AC Water main

Sheet No: _____ of 1

Calculated By: Fois Date 8/13/20

Scale: _____

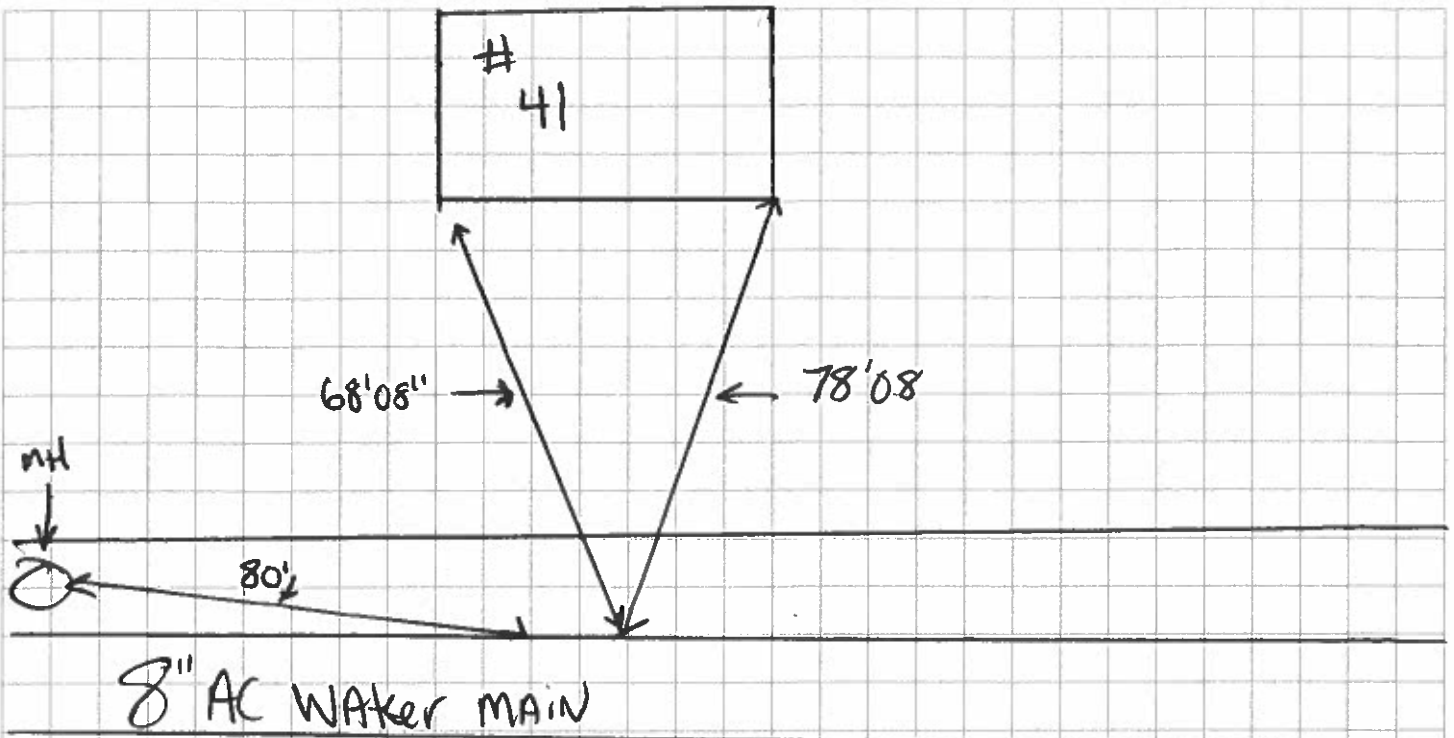

Bury Depth
4'11"