


53 AVERY ST

11-2021

#53

1" CTSP
M-C
13'

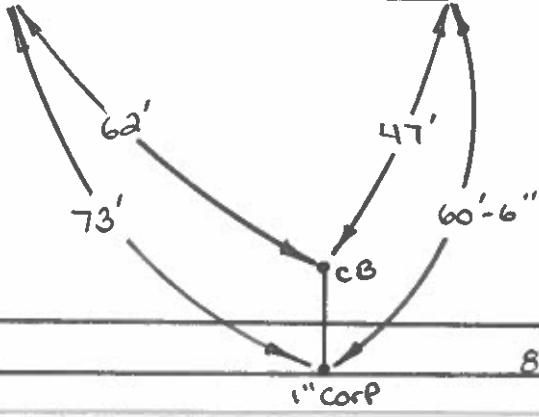

1" Corp

8" DI