


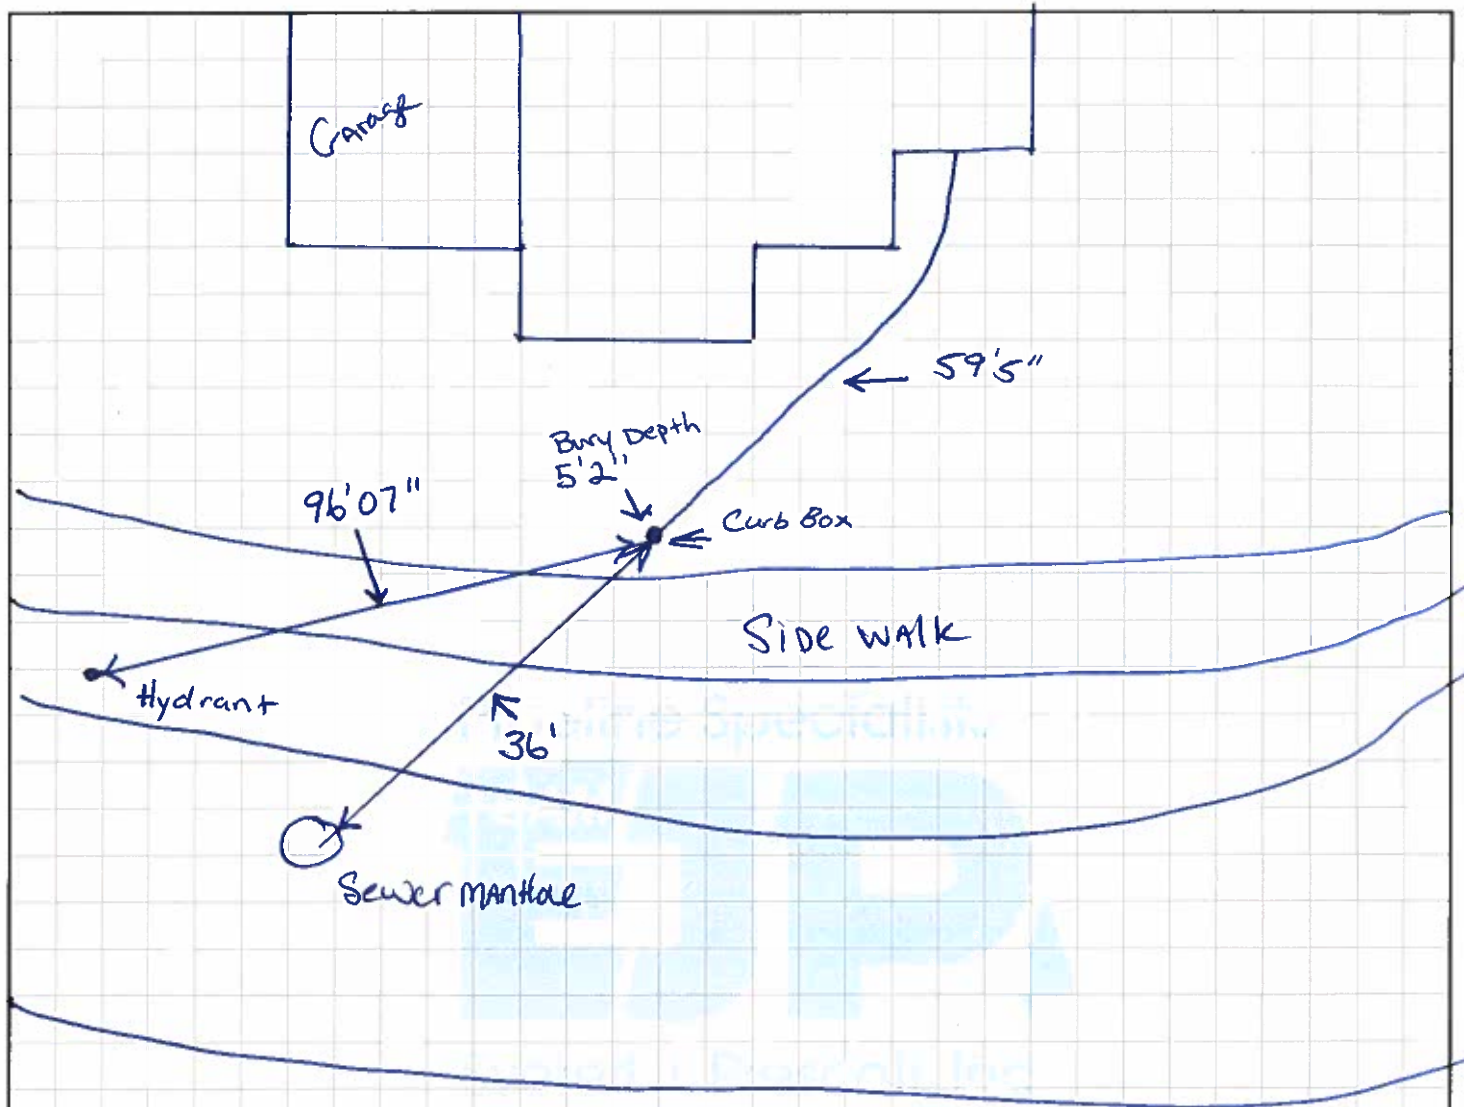

Water & Sewer
Installed by
Contractor (Skinner)