




EAST LONGMEADOW DEPARTMENT OF PUBLIC WORKS

Job: 14 Bellavista Water Service
Sheet No: 1 of 2
Calculated By: Fois Date: 7/22/20
Scale: Feet

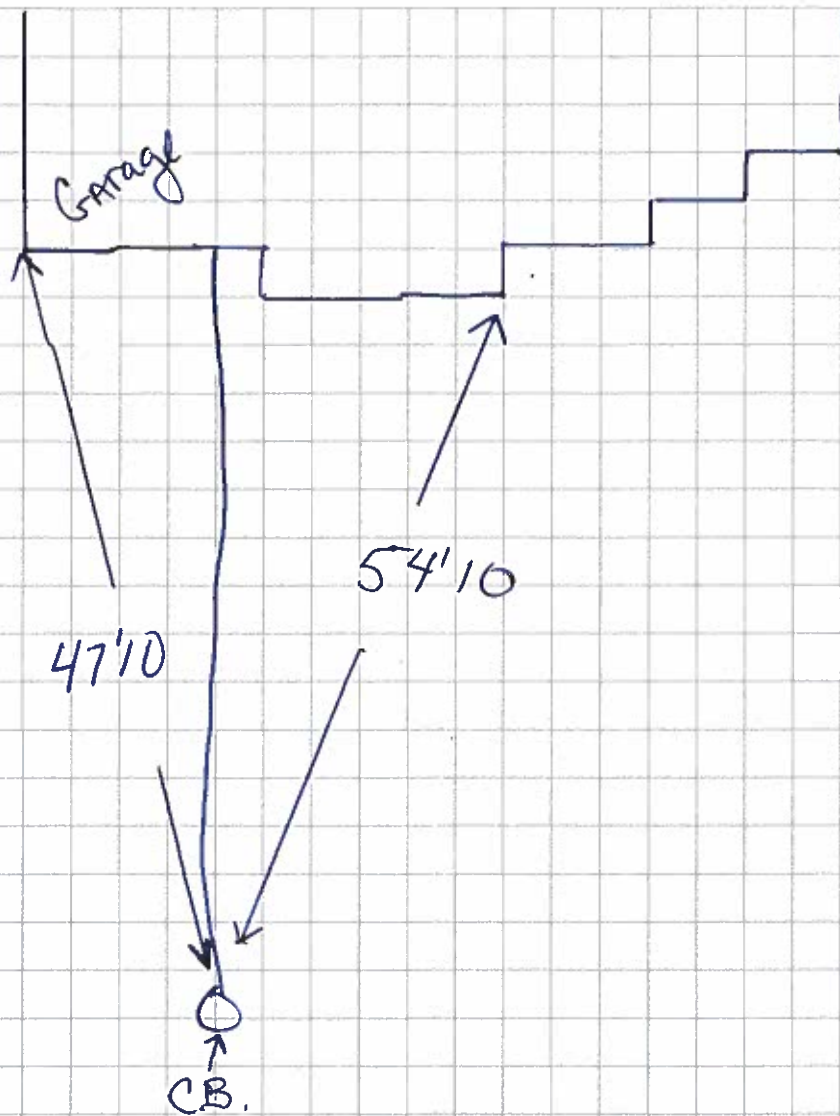

Bury depth - 5'00