


EAST LONGMEADOW DEPARTMENT OF PUBLIC WORKS

Job: 16 Bella Vista (water)
Sheet No: Excavator - Skinner Const. of _____
Calculated By: Pope Date 9-15-21
Scale: _____

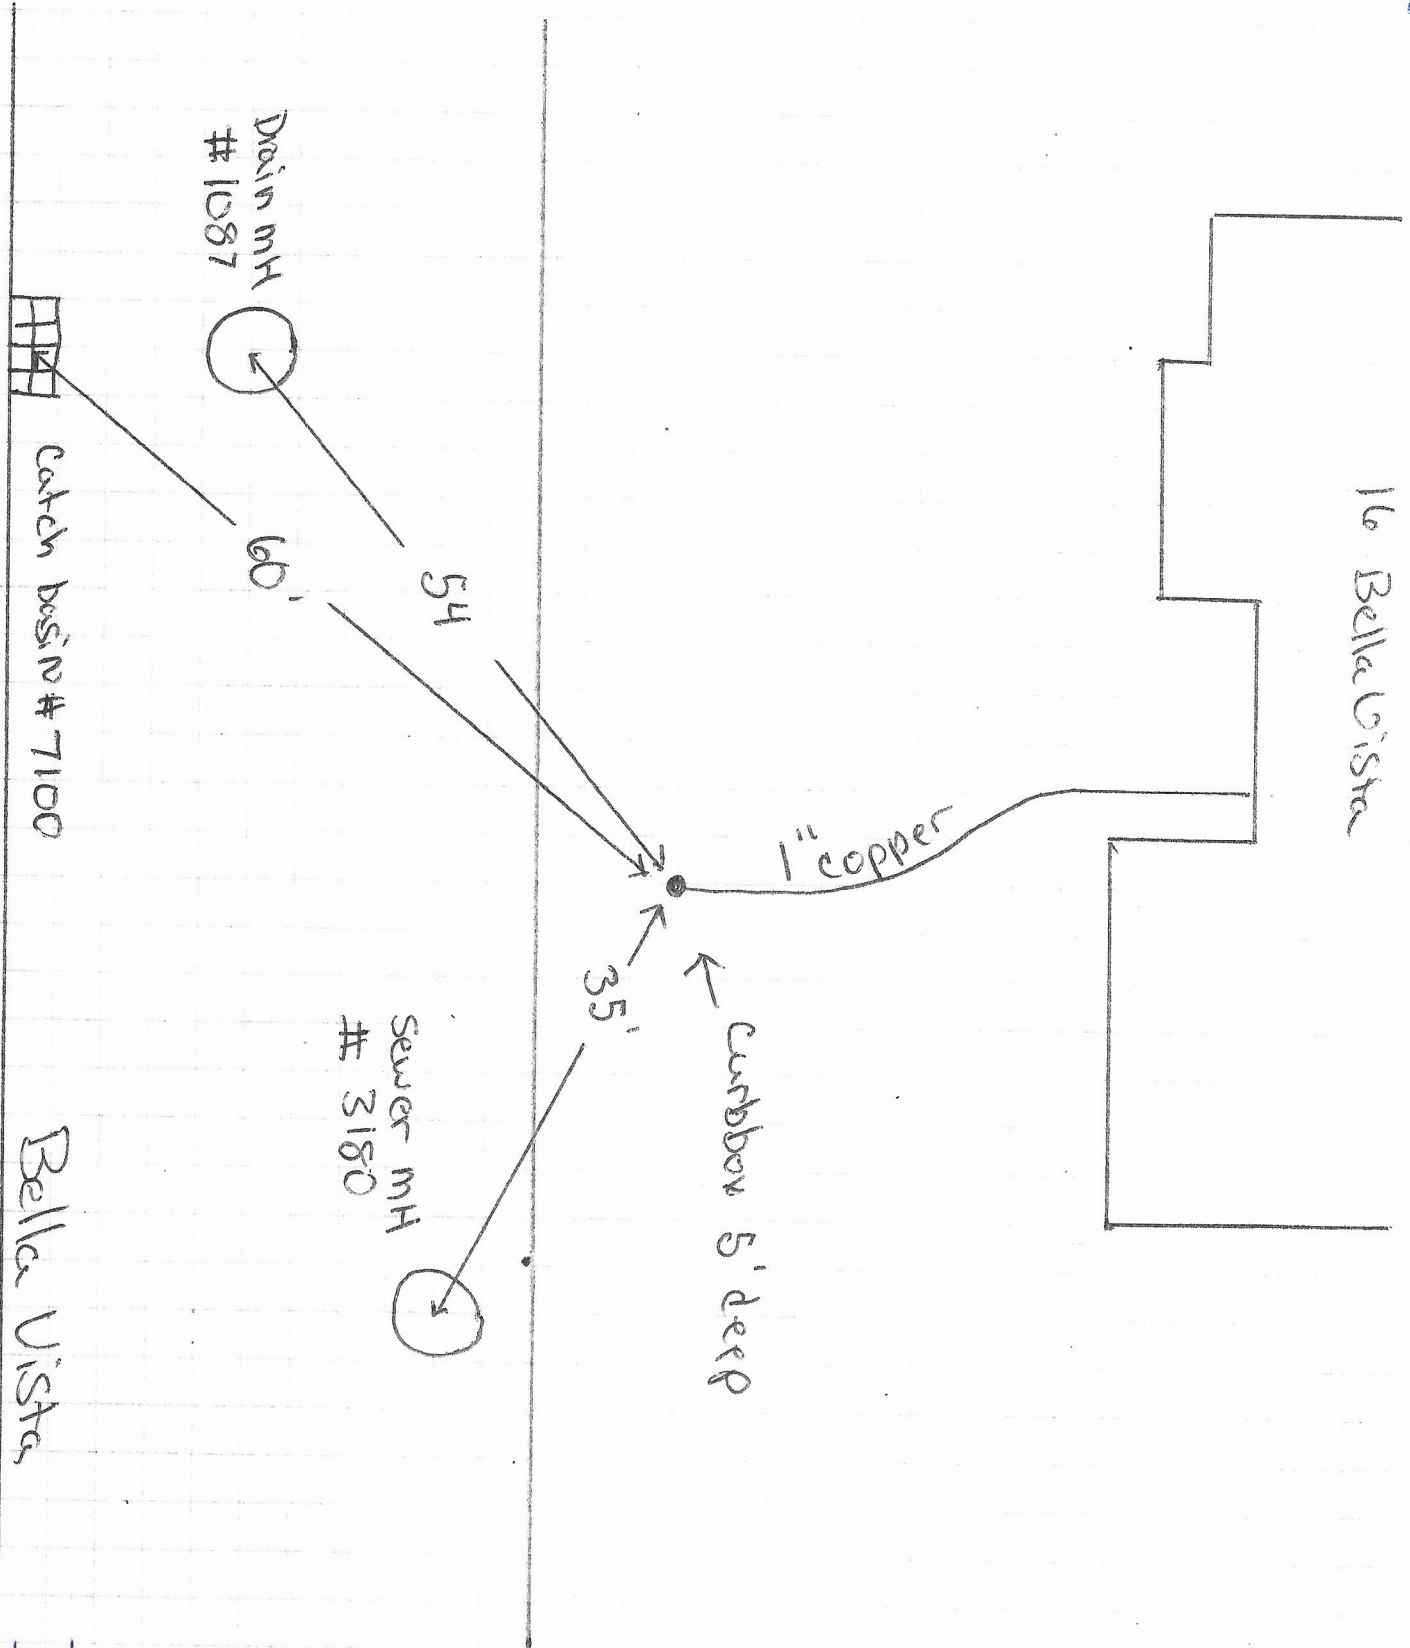

9/17/21 Scanned to GIS