


EAST LONGMEADOW DEPARTMENT OF PUBLIC WORKS

Job: 265 Benton Drive (water)

Sheet No: _____ of _____

Calculated By: Pope Date 4-9-19

Scale: 6" = 2" Water tap & Sleeve for new building

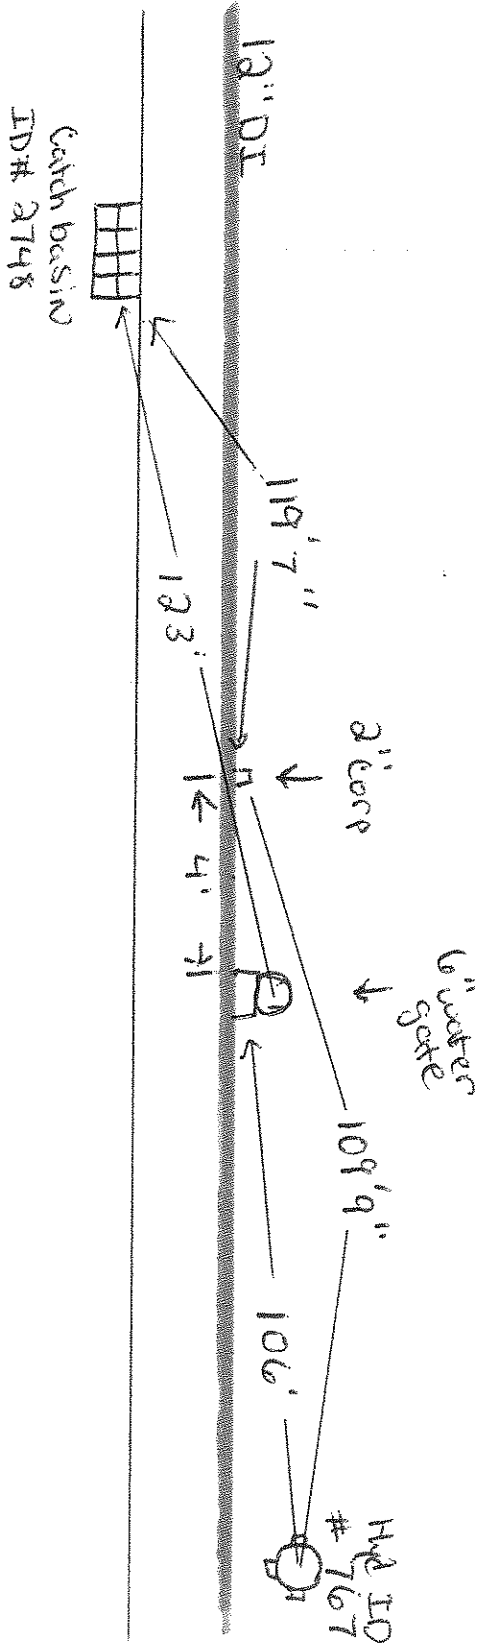

Benton Dr.