

NO. STREET


DATE INST.

MAKE:

SIZE

20 BETTERLEY LANE

11-7-13

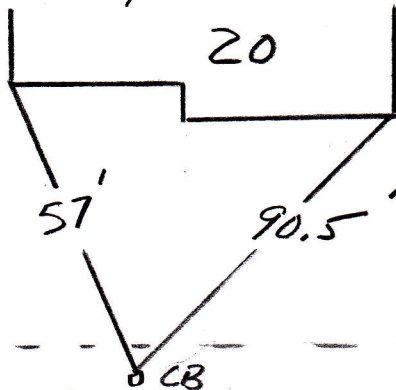

1" COPPER

SIDEWALK