


27 Betterley Lane

C.B. in Driveway

#27

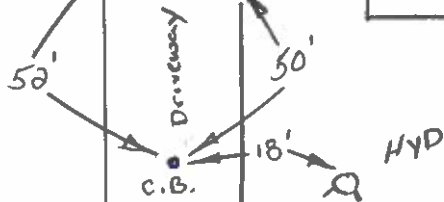

Betterley
Cul-De-Sac