


16 Black Dog Lane

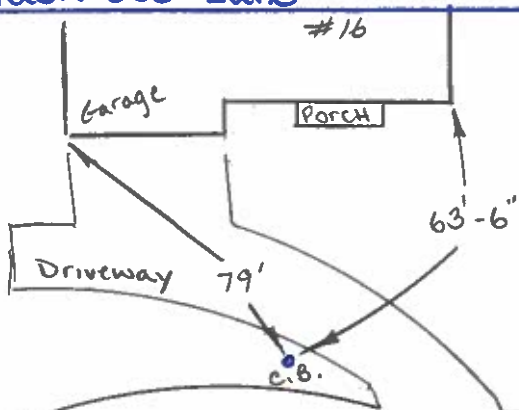

Black Dog