




EAST LONGMEADOW DEPARTMENT OF PUBLIC WORKS

Job: Water Curb Box

Sheet No: 23 Black Dog Lane of       

Calculated By:        Date 12-1-16

Scale:       

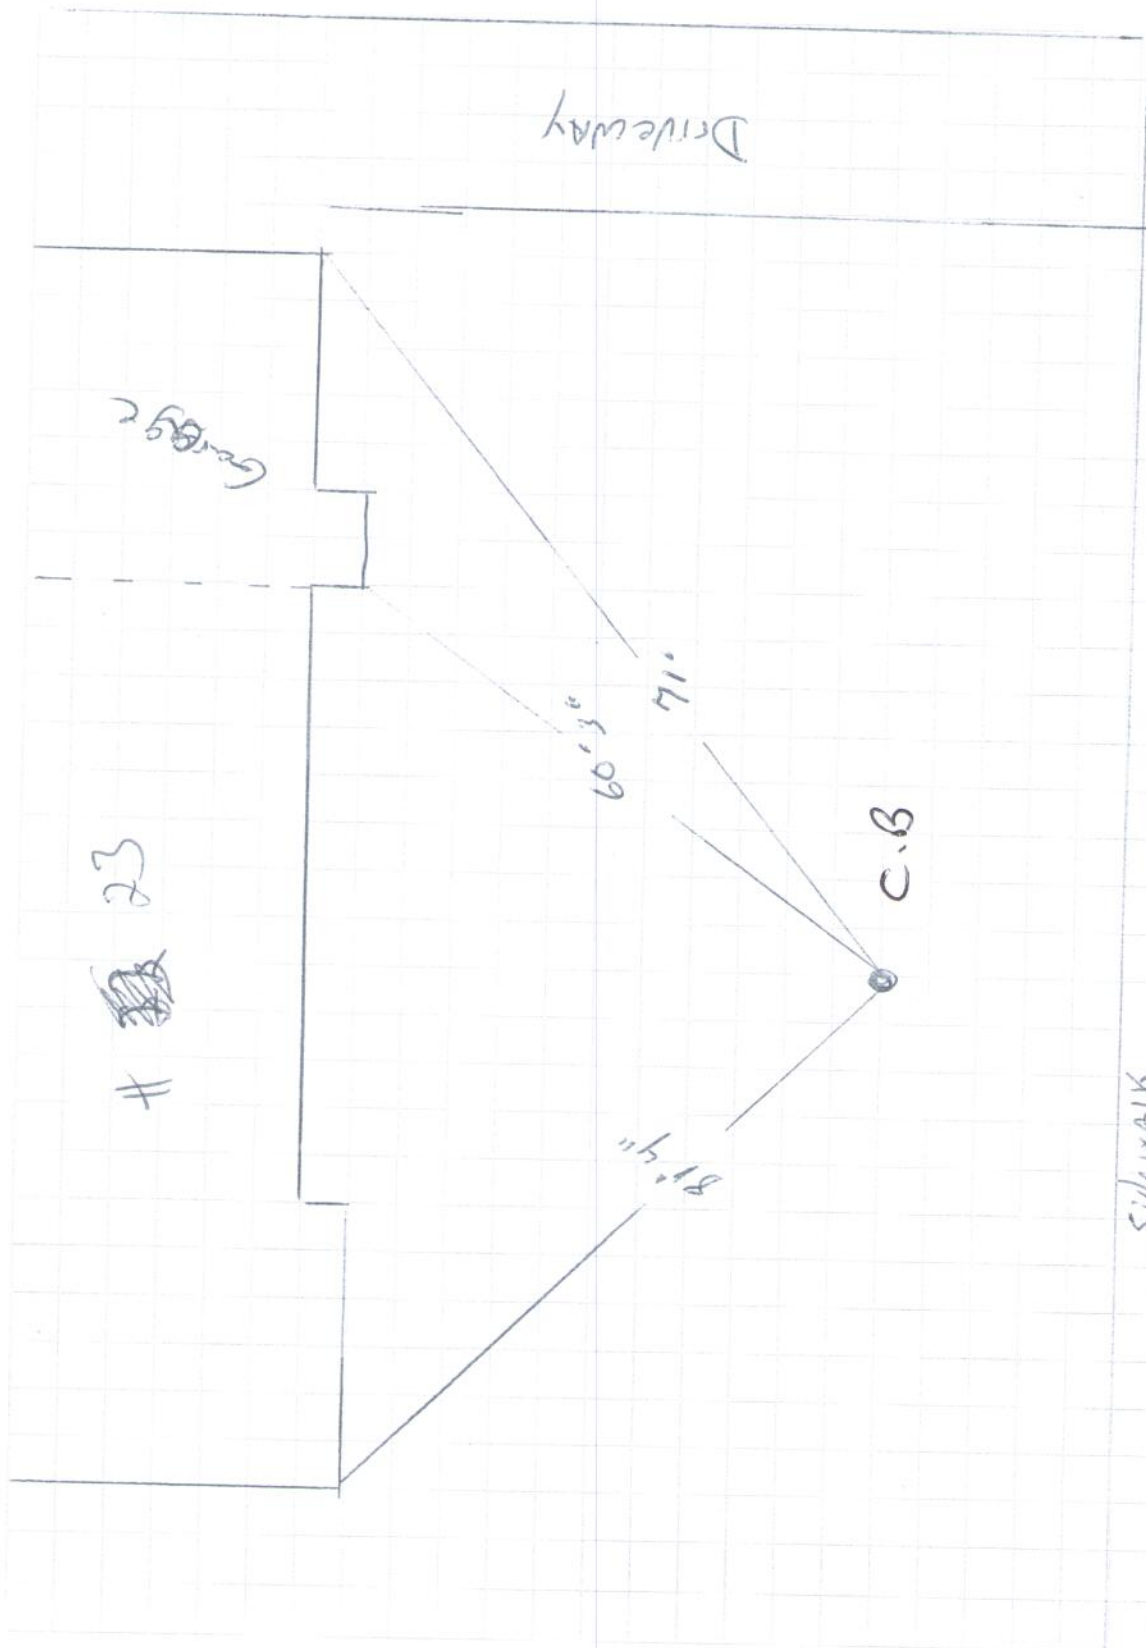

SIDEWALK

Black Dog Lane