




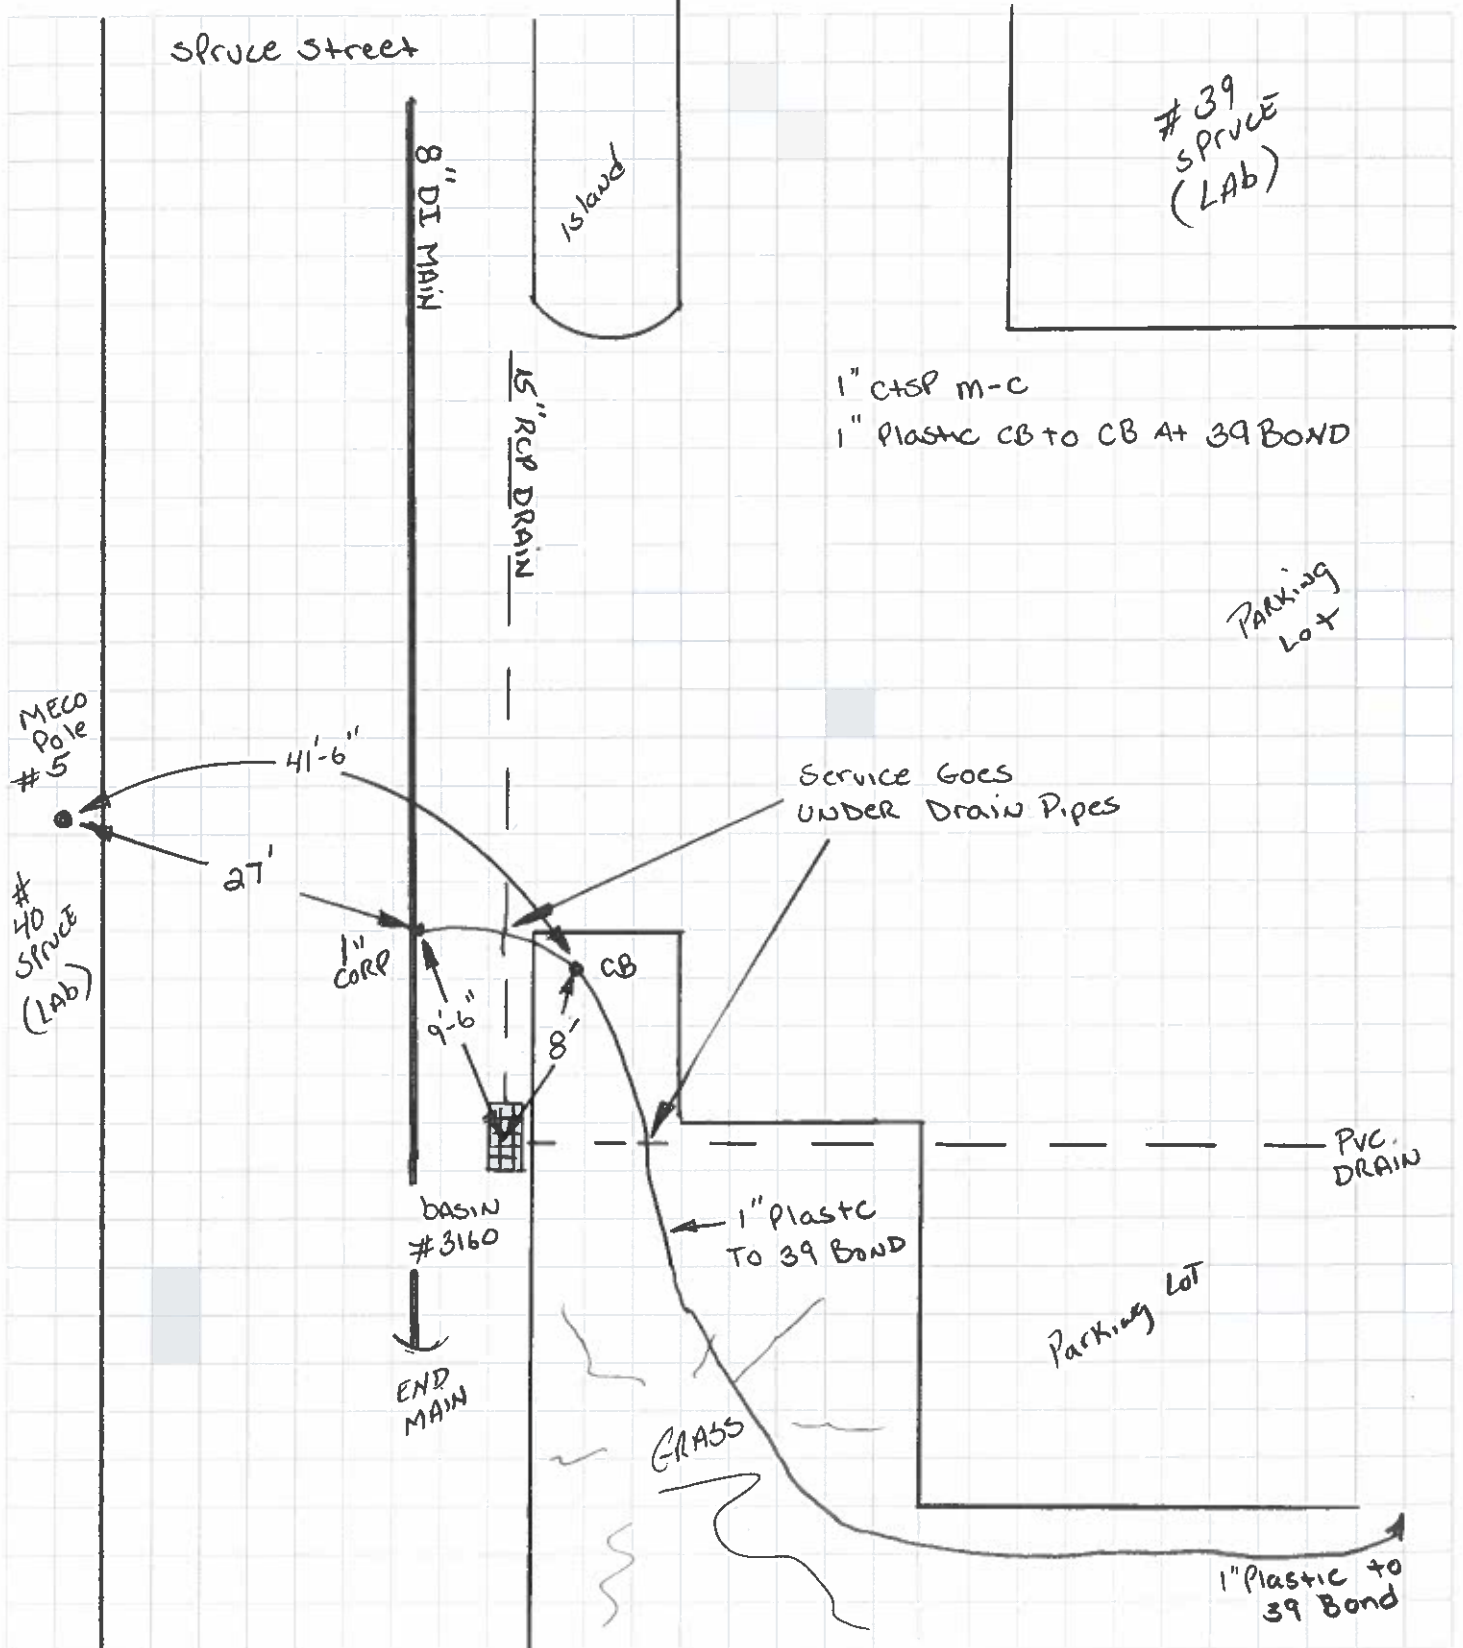

EAST LONGMEADOW DEPARTMENT OF PUBLIC WORKS

Job: 39 Bond (water)

Sheet No: _____ of _____

Calculated By: Pope Date: 12-12-2022

Scale: Sheet 2 of 2

Bond

39 Bond

