


CALKINS AVENUE - #7

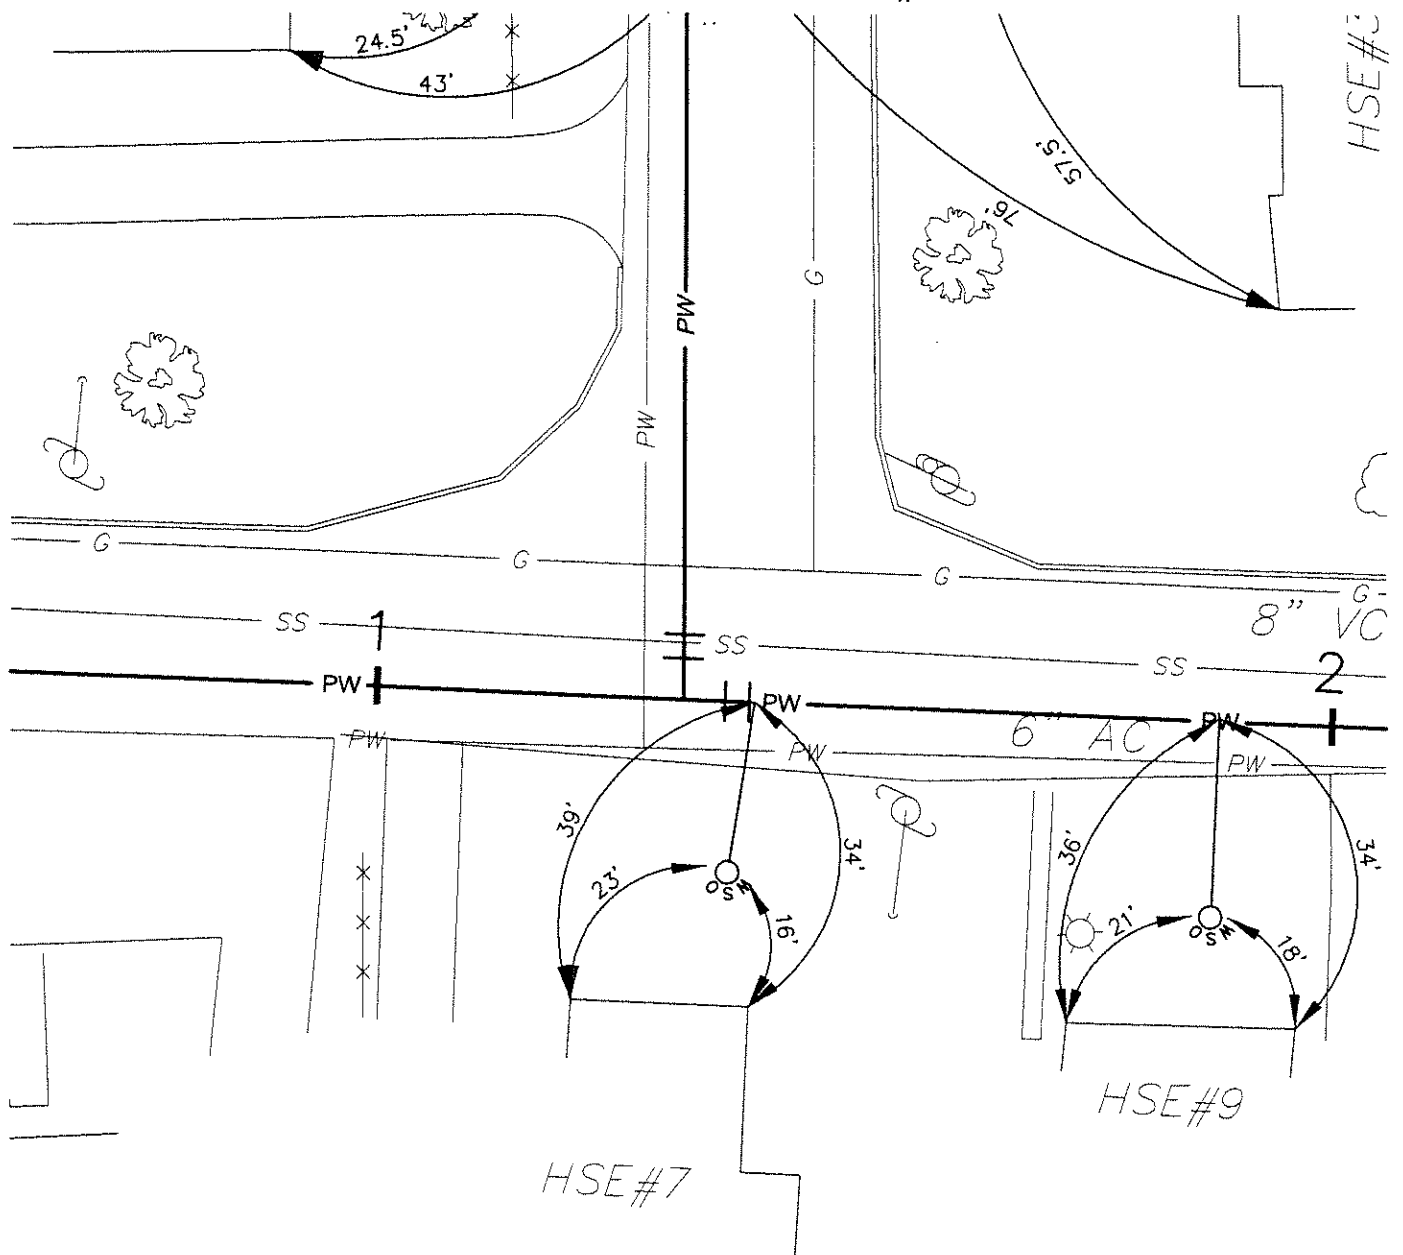

HOUSE SERVICE INFORMATION:

DEPTH AT MAIN: 5'
 DEPTH AT PROPERTY LINE: 5'
 DATE INSTALLED: 10/05/04

PREPARED BY TIGHE & BOND