


11 CALKINS AVENUE

10-5-04

#11

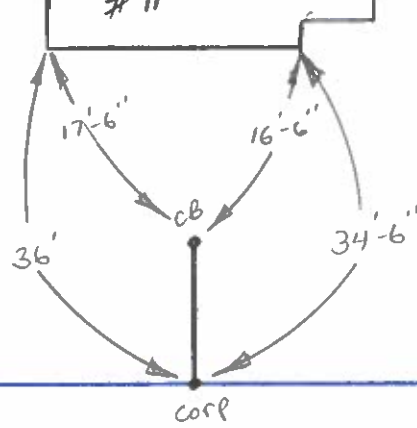

8" DI