


13 CALKINS AVENUE

10-5-04

#13

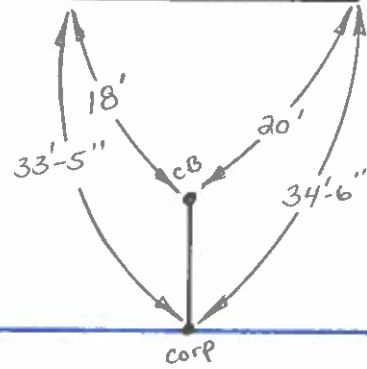

8" DI