


CALKINS AVENUE - #19

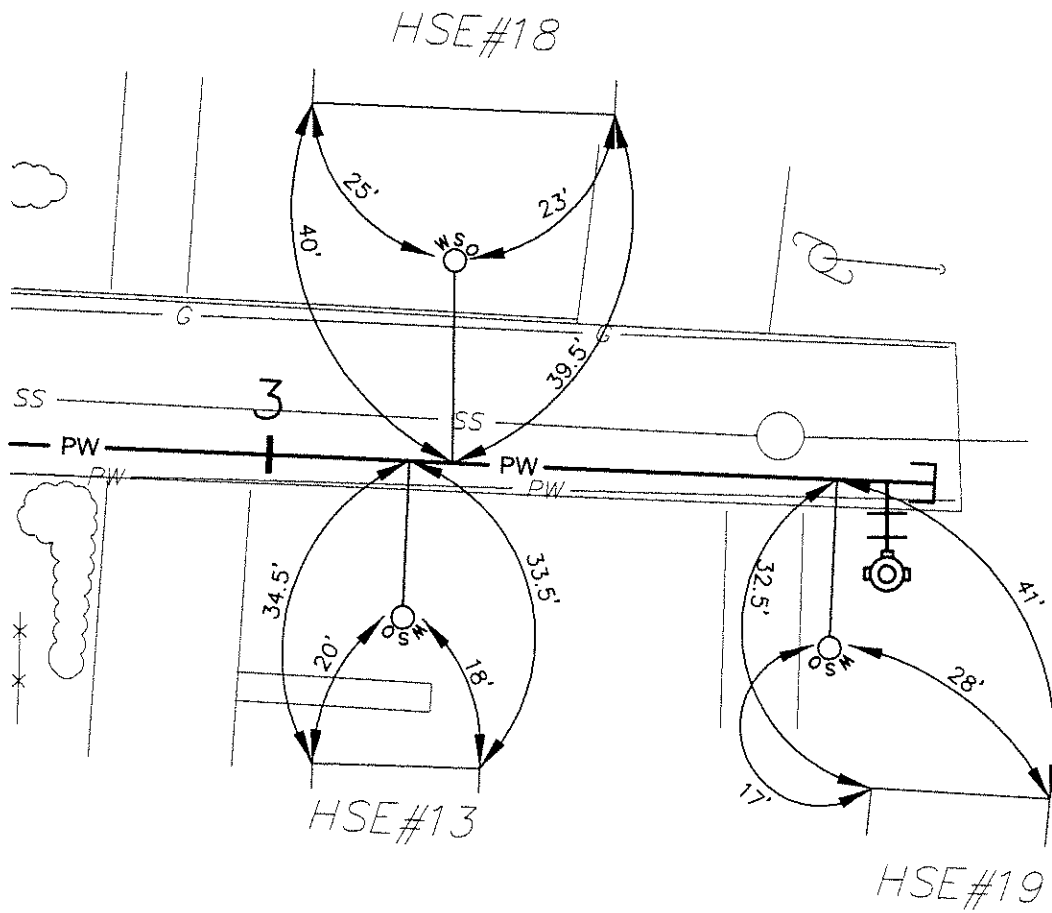

HOUSE SERVICE INFORMATION:

DEPTH AT MAIN: 5'
DEPTH AT PROPERTY LINE: 5'
DATE INSTALLED: 10/05/04

PREPARED BY TIGHE & BOND