


19 CALKINS AVENUE

10-5-04

#19

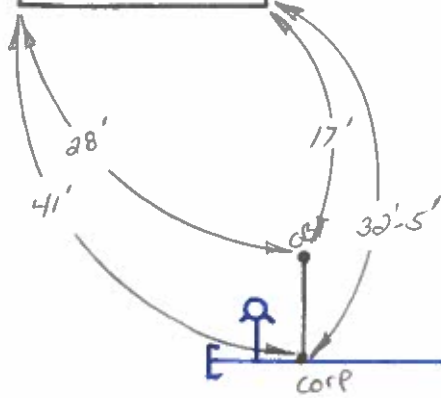

8" DI