


146 Canterbury Circle

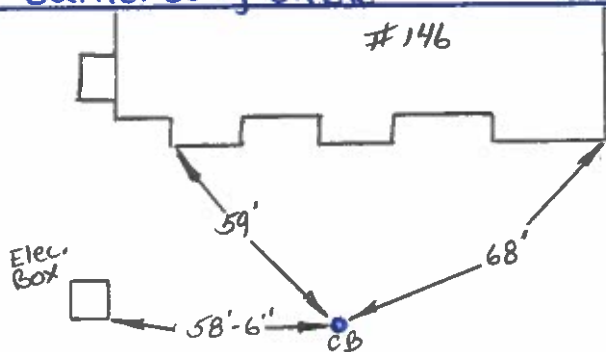

Canterbury