



EAST LONGMEADOW DEPARTMENT OF PUBLIC WORKS


Job: 146 Canterbury Cir

Sheet No: Curbox Ties of \_\_\_\_\_

Calculated By: Josh C.

Date 3-24-16

Scale: \_\_\_\_\_

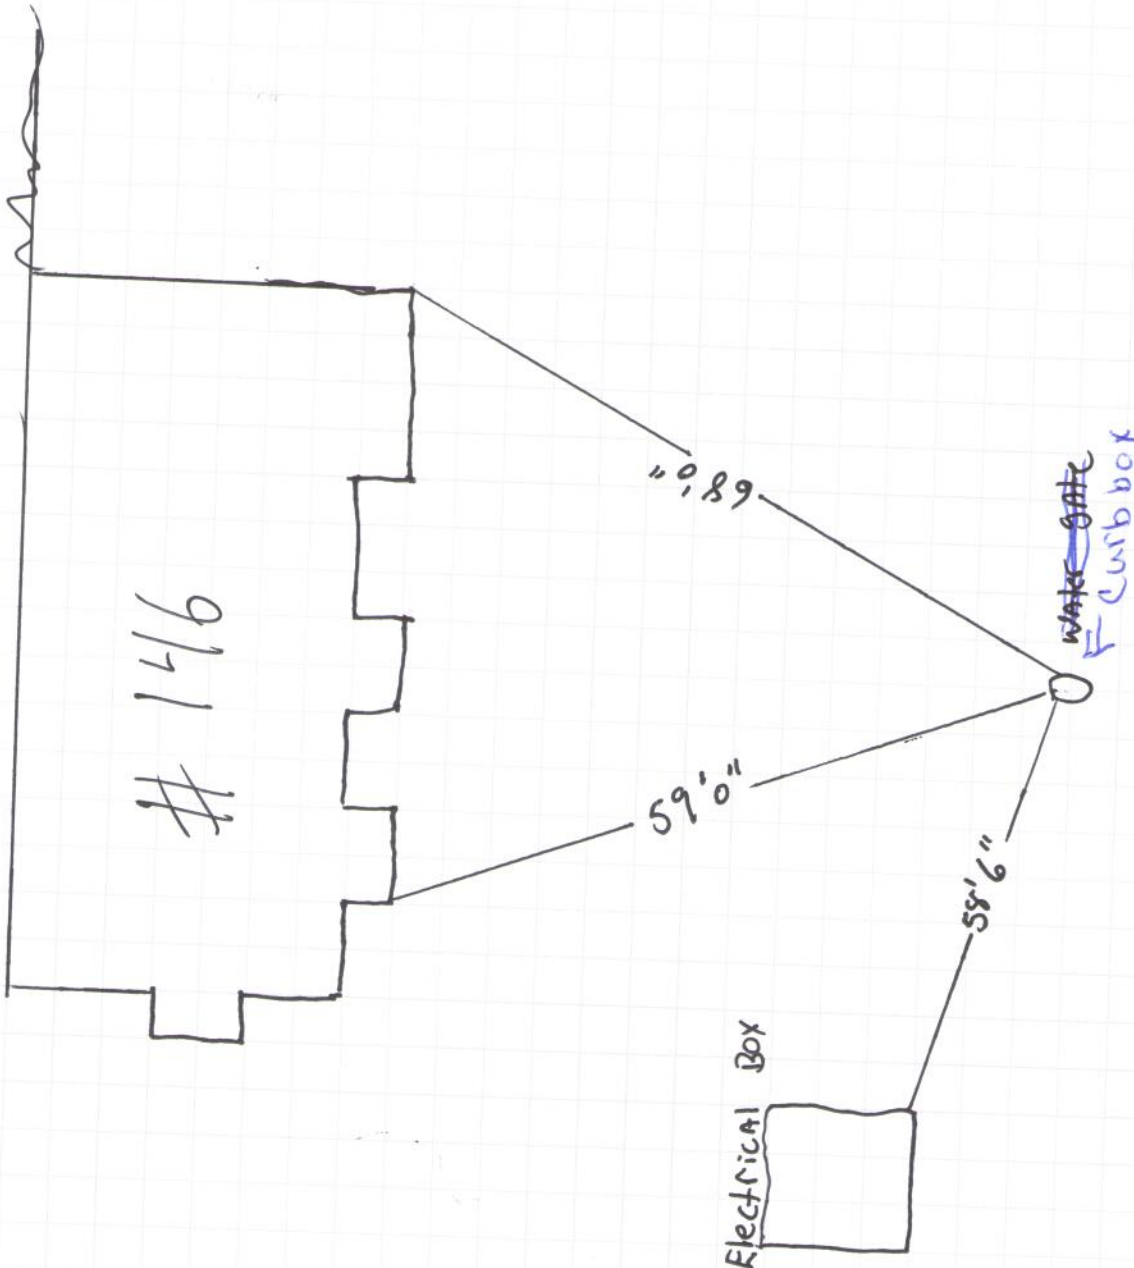

Canterbury Cir