

NO. STREET

DATE INST.


MAKE:

SIZE

160 CANTERBURY CIR

10-18-13

160

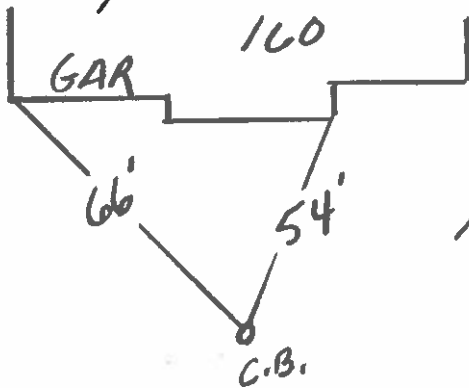

1" COPPER