


167 Canterbury Circle

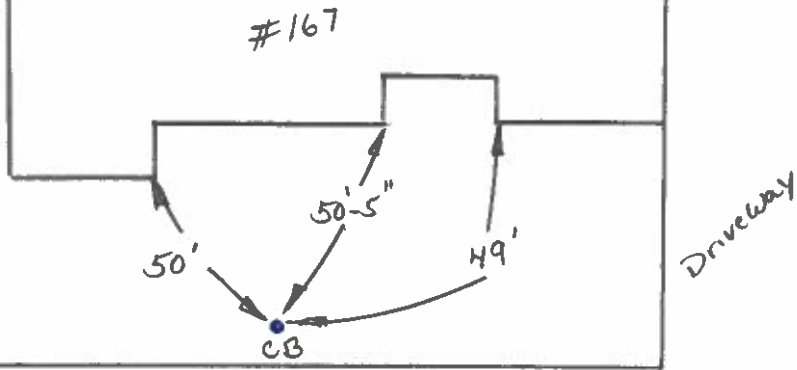

Canterbury