

EAST LONGMEADOW DEPARTMENT OF PUBLIC WORKS


Job: 6 Capri (water)

Sheet No: _____ of _____

Calculated By: Pope Date 5-30-18

Scale: _____

Capri

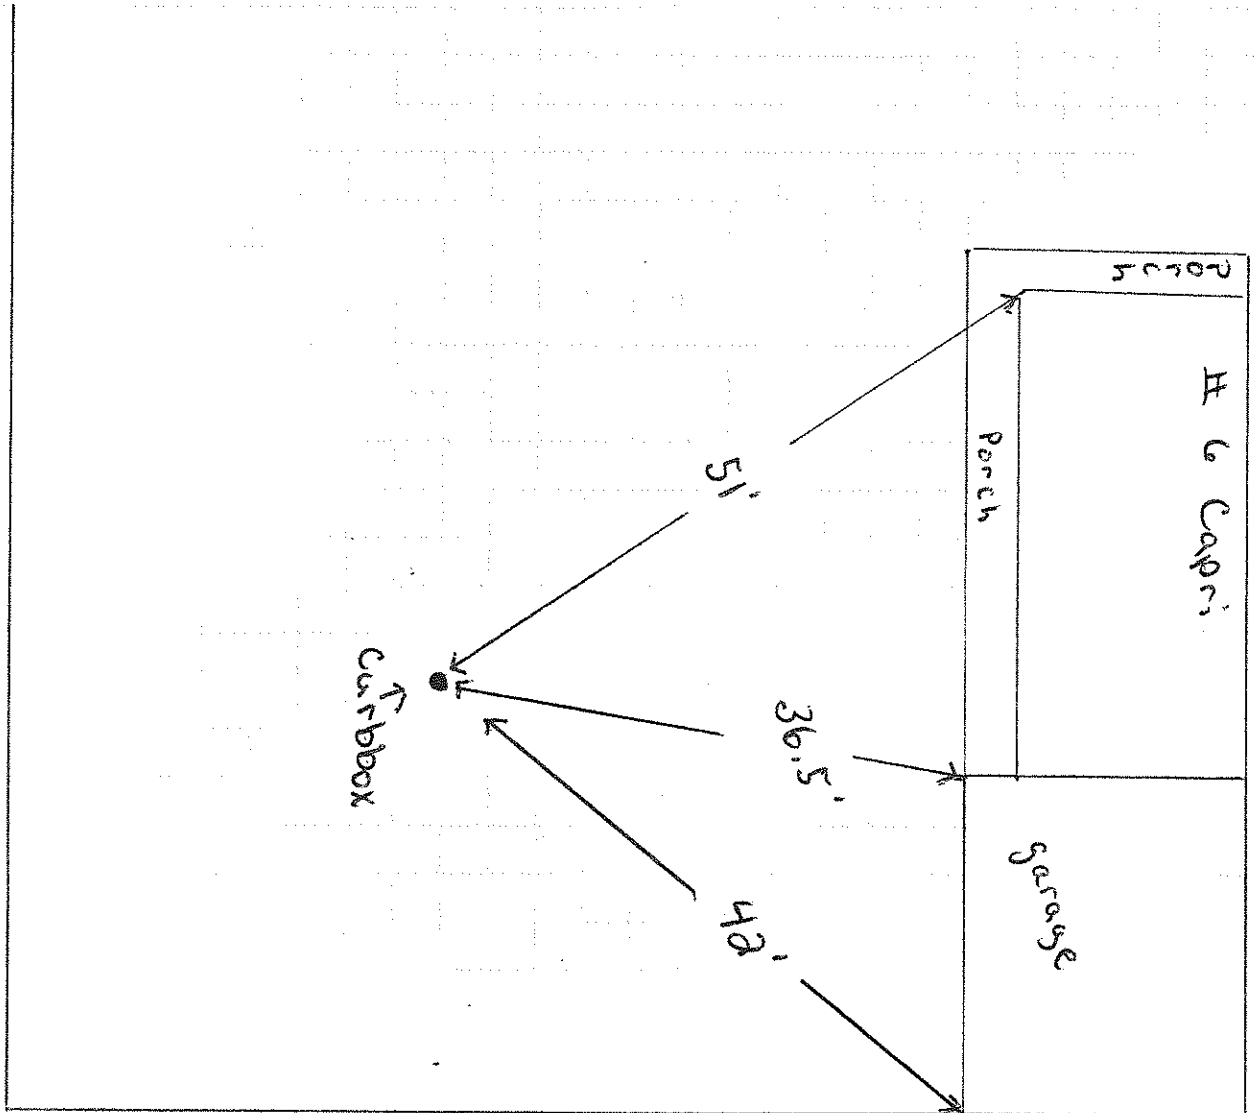

OR 4214342