


EAST LONGMEADOW DEPARTMENT OF PUBLIC WORKS

Job: 24 Capri (water)

Sheet No: _____ of _____

Calculated By: Pope Date 10-1-19

Scale: _____

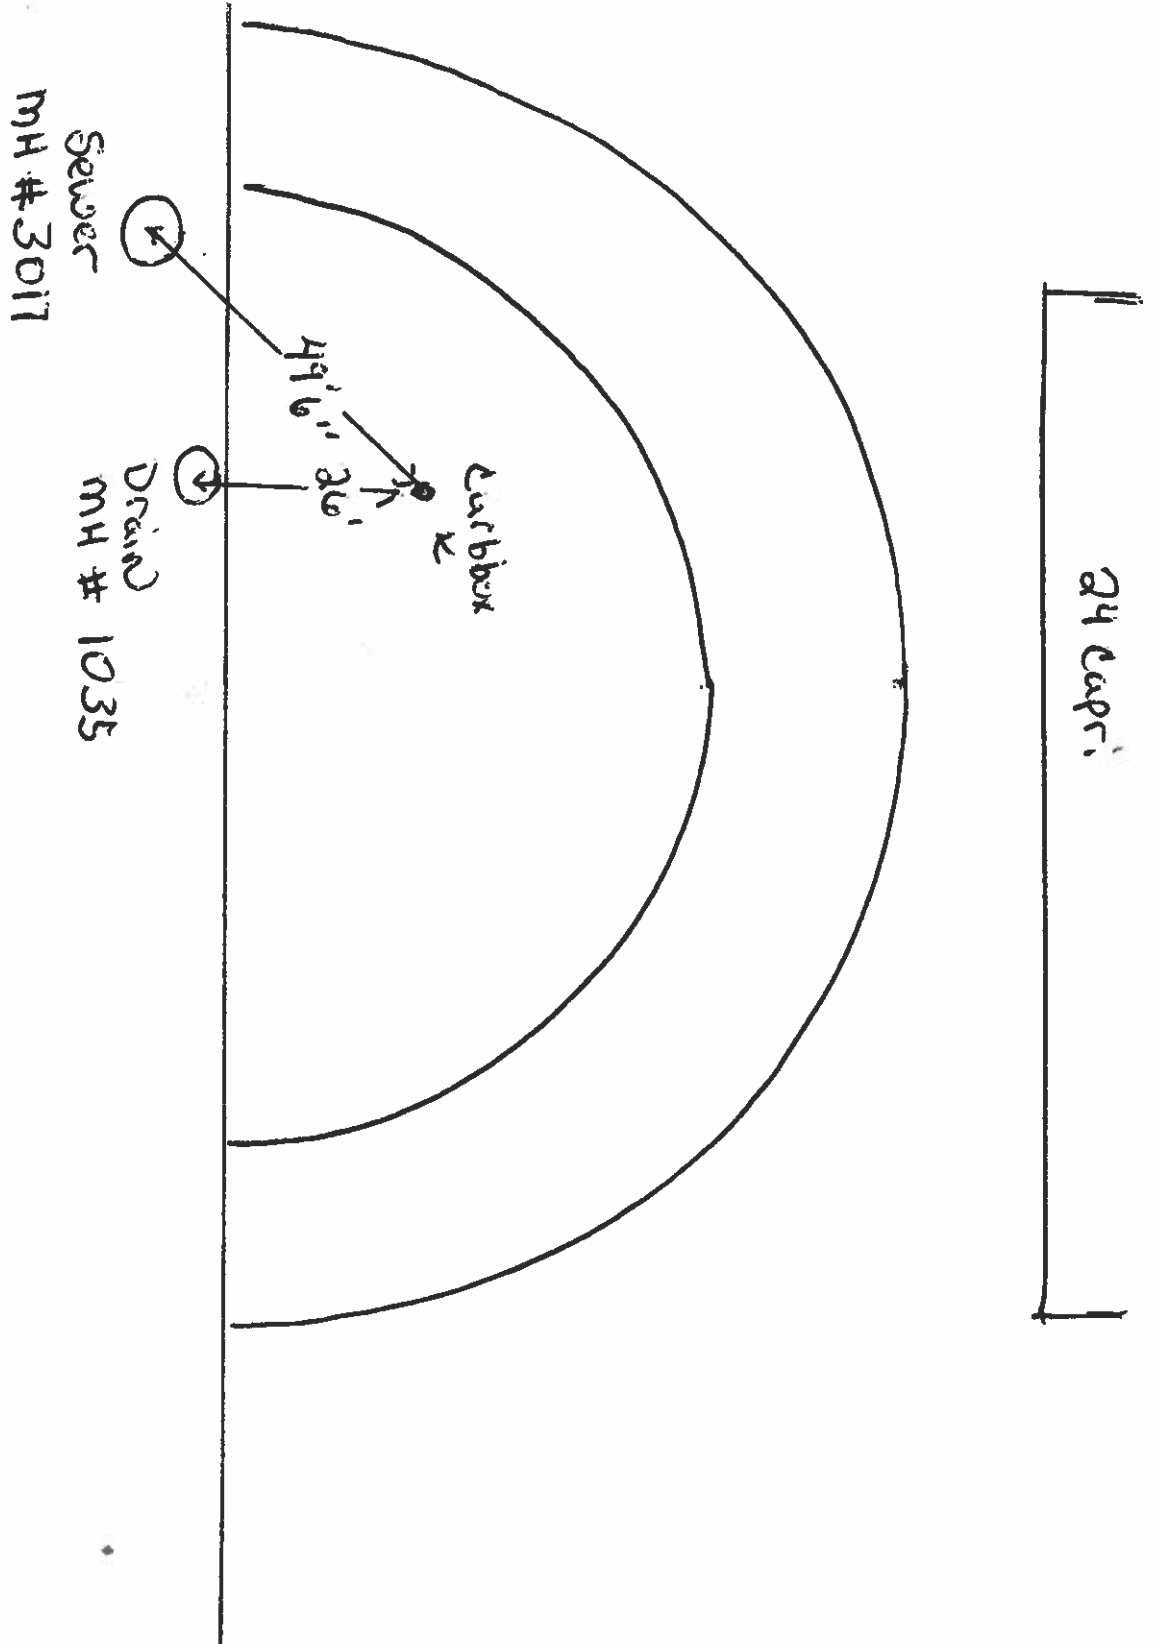

Capri