


54 Capri Drive

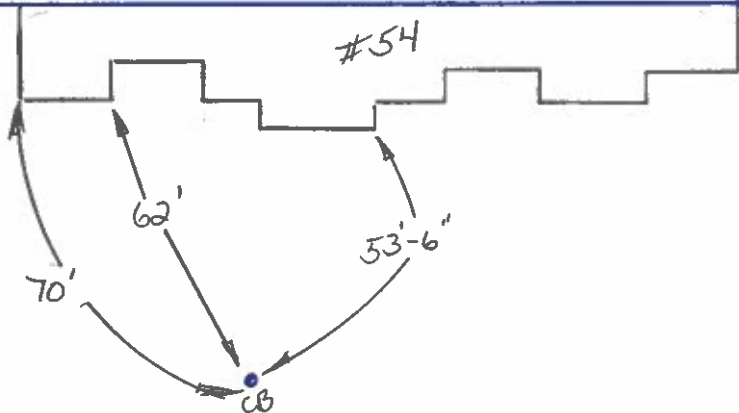

CAPRI