

No. 107 Carol Ann

Street

Owner Premium Homes Inc.

S. R. 710408

Date

6-12-71

Work Done

Service pipe laid by M. Cunningham


John J. Lefter

Buffalo box in st. over 1" IK made onto 3/4" corp.,
42'10" out from house, 6'10" S of N line of house, 33'4"
N of S line of house, 53'0" S of S line of #115.

44'0" $\frac{3}{4}$ " C.T.B. DEPT.

115

107

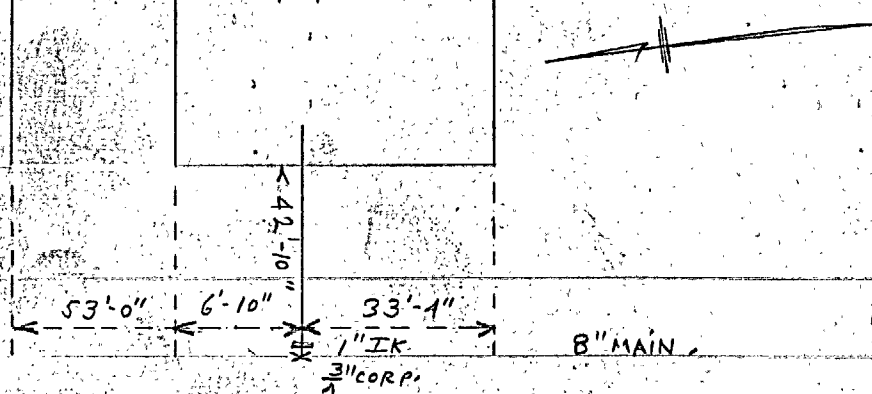

CAROL ANN STREET.