

No. 116 Carol Ann

Street

Owner Premium Homes Inc.

S. R. 710411

John E. Unigen

Date

6-28-71


Work Done

Turned on 10/7/71 A.P.



Service pipe laid by - M. Cunningham

Buffalo box in st. over 1" IK made onto 3/4" corp.,
Tapped on top., 56'7" out from house, 1'6" S of N line
of house, 38'4" N of S line of house, 12'1" SW of hydt.

58'0" $\frac{3}{4}$ " C.T. By DEPT.

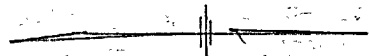

116

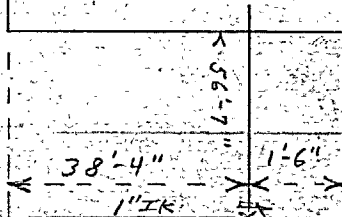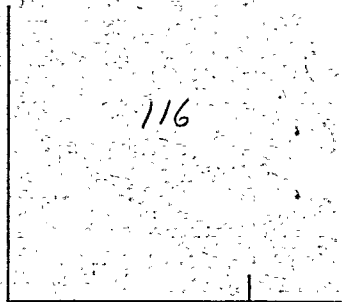

8" MAIN

3" CORP.

CAROL ANN STREET.

HYD.