

No. 134 Carol Ann

Street

Owner William McNutt

S.R. 64724

Date	Work Done
11-24-65	Service pipe laid by-Clayton Krusiewicz


Buffalo box in st. over 1" IK made onto 3/4" corp.

55'5" out from foundation of house, 3'7" S of N line

39'2" N of S line of house, (see pipe enters bldg.
on S side of house).

70'0" $\frac{3}{4}$ " C.T. By D.E.U.

11/24/65
KRUSIEVICZ

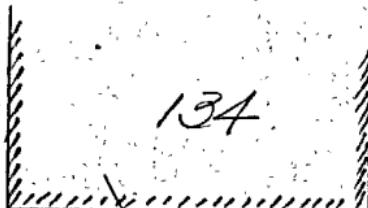

CAROL ANN St

$\frac{3}{4}$ " C.R.P.