

No. 189 Carol Ann

Street

Lot #45

Owner Frank C. Gotta

S. R. 700042A

Date

Work Done

5-21-70

Service pipe laid by Cunningham, to treebelt

10-6-70

Dug up corp, repaired leak at wedge-Salvetti

10-17-70


Extended service into cellar & set meter-Roncarati

Buffalo Box in st. over 1" IK made onto 3/4" Corp.

19'2" N of S line of house, 24'4" S of N line of house,

45'0" out from house, 36'8" S of S line of #195.

11'0" - 3/4" C.T. by Sept. - to treebelt - 1970.
37'0" - 3/4" C.T. from by Sept. extending into cellar - 1970

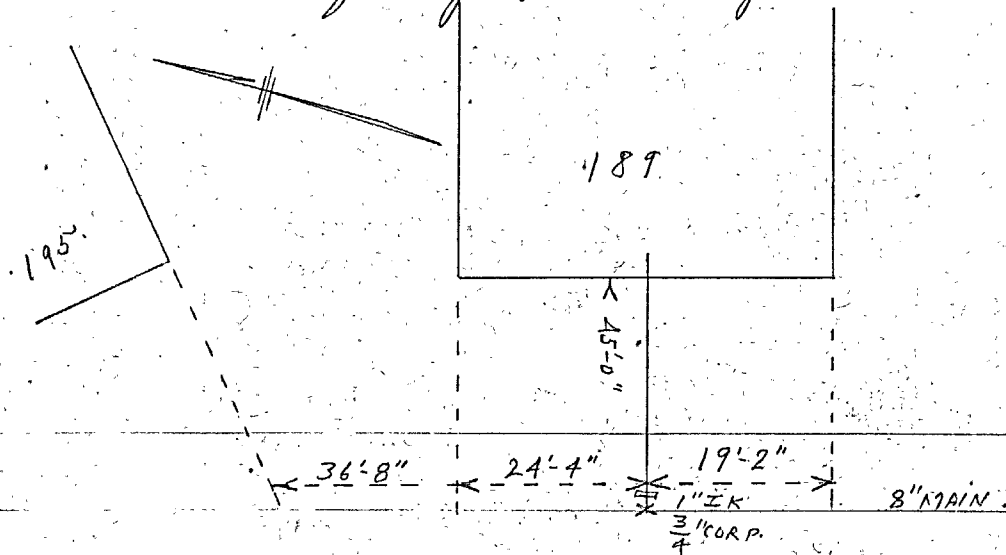

CAROL ANN STREET.