

No. 68 Carol Ann
Owner Premium Homes Inc.
Street Lot #13

S. R. 700970


Date
5-26-71

Work Done
Service pipe laid by M. Cunningham
Left mat IK.

Buffalo box in st: over 1" IK made onto 3/4" corp.,
55'10" out from house, 3'4" S of N line of house, 35'7"
N of S line of house, 30'3" SE of tel. box #9.

57'6" $\frac{3}{4}$ " C. J. By Dept.

68

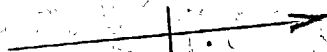

55'10"

8" MAIN

35'7"

1" JK
3/4" CORP.

3'4"

30'3"

TEL BOX #9

CAROL ANN ST