

No. 73 Carol Ann Street Lot#7

Owner Premium Homes Inc.

S. R. 700971

Date
5-17-71


Work Done

Service pipe laid by J. Shaughnessy

Buffalo box in st. over 1" IK made onto 3/4" corp.,
43'8" out from house, 3'6" N of S line of house, 40'7"
S of N line of house, 18'6" W of E line of st., 10'8"
S of N line of house #68.

45' 4" $\frac{3}{4}$ " C.T. BY DEPT.

73

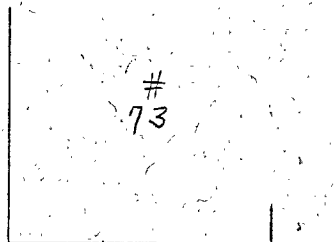

40'-7" 10'-8" 3'-6"

1" I.K.
3" C.R.P.

5'-8" 1"

8" MAIN

CAROL ANN STREET.

68

