


CAROL ANN ST.

8" SHAMMOON-CLISO-CEM. LINED-18' LGTHS-HYDROTITE NOV. 1965 - J. SALVETTI
8" U.S. " " " " " " TYTON MAY 1970 - BRUSCHI BROS.

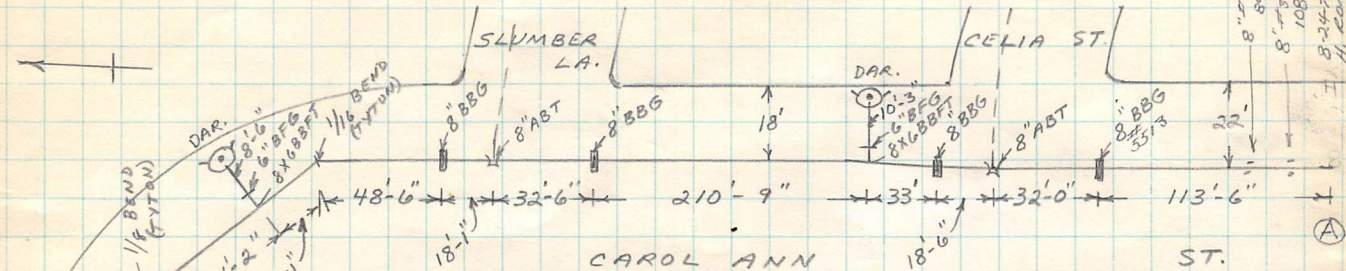

18-6
33-0
210-9
32-6
18-1
48-6
14-11
54-2
89-6
90-9
610-8 MAY 1970

32-0
113-6
145-6 NOV. 1965

8" SHAMMOON-CLISO-CEM. LINED-18' LGTHS-HYDROTITE NOV. 1965 - J. SALVETTI
8" U.S. " " " " " " TYTON MAY 1970 - BRUSCHI BROS.