

No. 84 Celia

Street

Lot 26

Owner Gralia Bros.

S. R. 56777

Date

4-18-57


Work Done

Service pipe laid by R. Haraty

Buffalo box in st. over 1" IK made onto 3/4" Corp.  
63'2" out from line of house, 38'6" E of W line of  
house, 4'0" W of E line of body of house, 65'4" W of  
W line of house #76.

65104-34' Copper Tubing

APRIL 18 1957. HARATY.

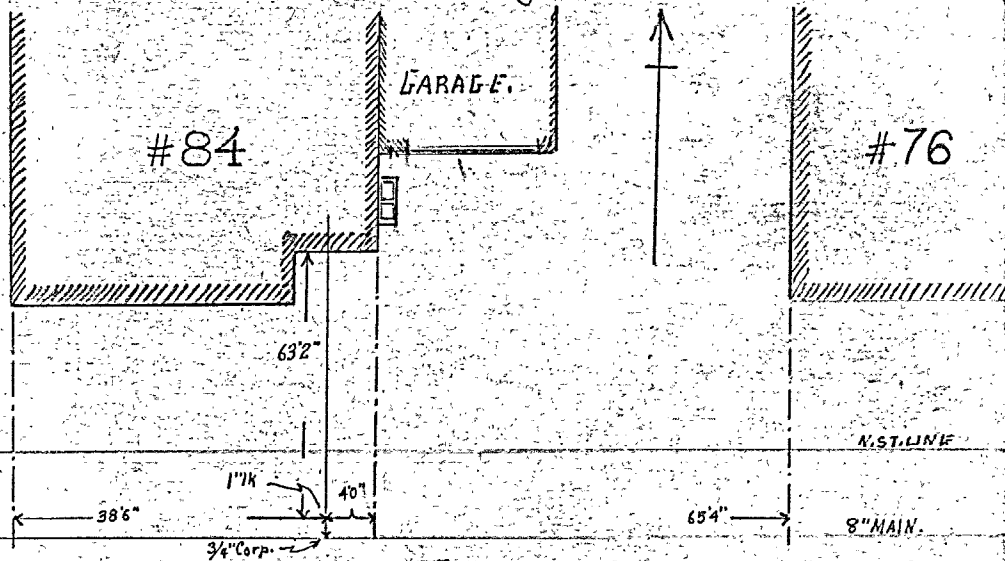

CELIA ST.

S. ST. LINE