


CELIA ST.  
 8" WARREN, C1-150 CEM. LINED, 16' LENGTHS, HYDRATITE, NOV. 1956 W. MASS CONSTR.  
 8" SHAMMOON " " " " 18' " " NOV. 1965 J. SALVETTI

SLUMBER LANE

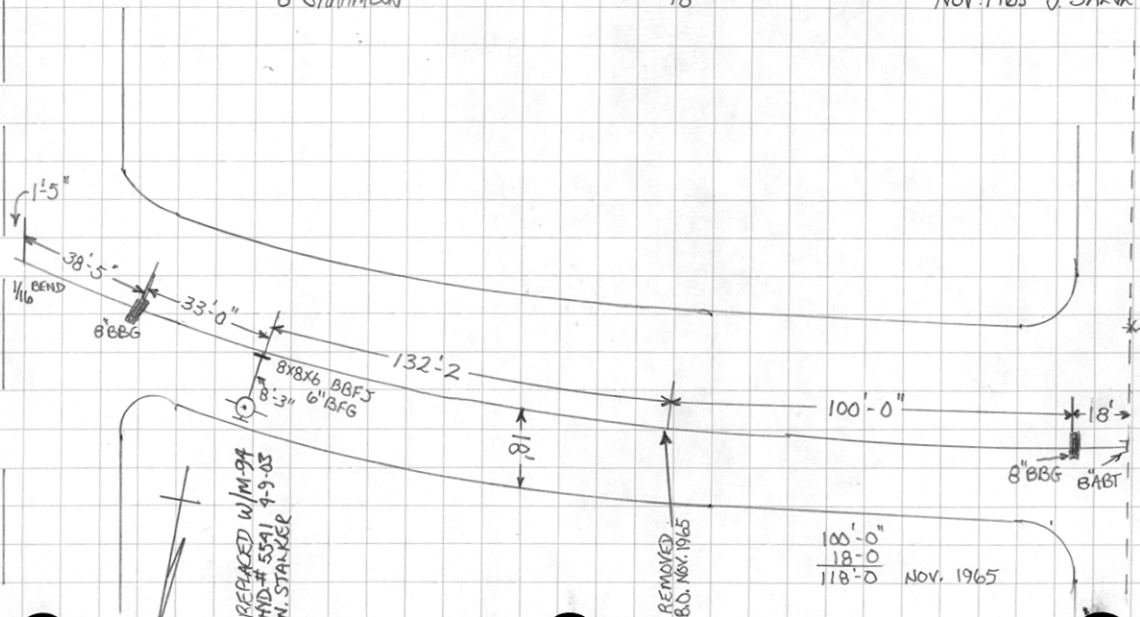

CAROL ANN ST.