

NO. STREET:

DATE INST:

MAKE:


SIZE

6, 8, 10
Center Square

1/1/47

Pittsburg

5/8"

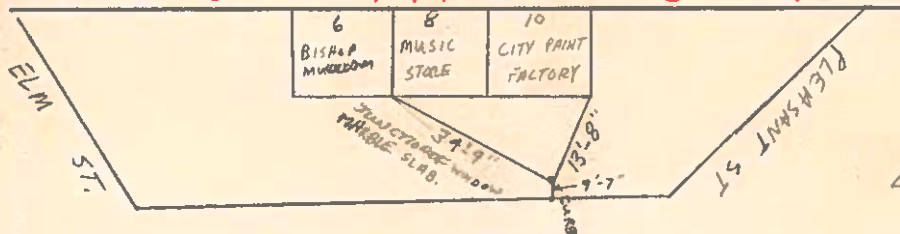

CENTER SQ.