




EAST LONGMEADOW DEPARTMENT OF PUBLIC WORKS

303 ~~300~~ Job: Chestnut St (water)

Sheet No: In front of lenox of

Calculated By: Pope Date 8-12-19

Scale:

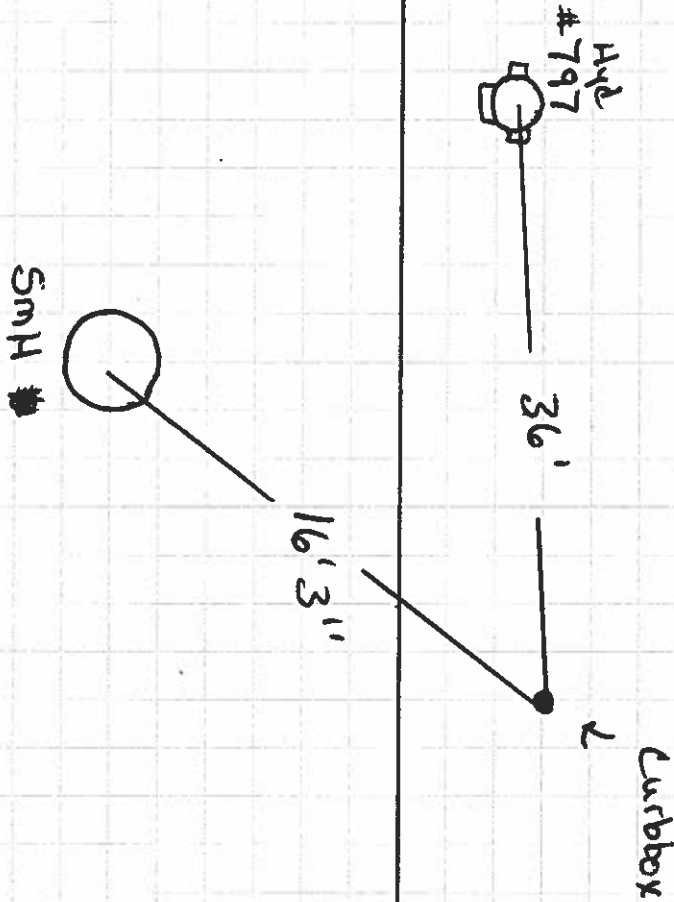

This is a 3/4" service
stub not in use but
still live to the main
3'6" deep in the road