


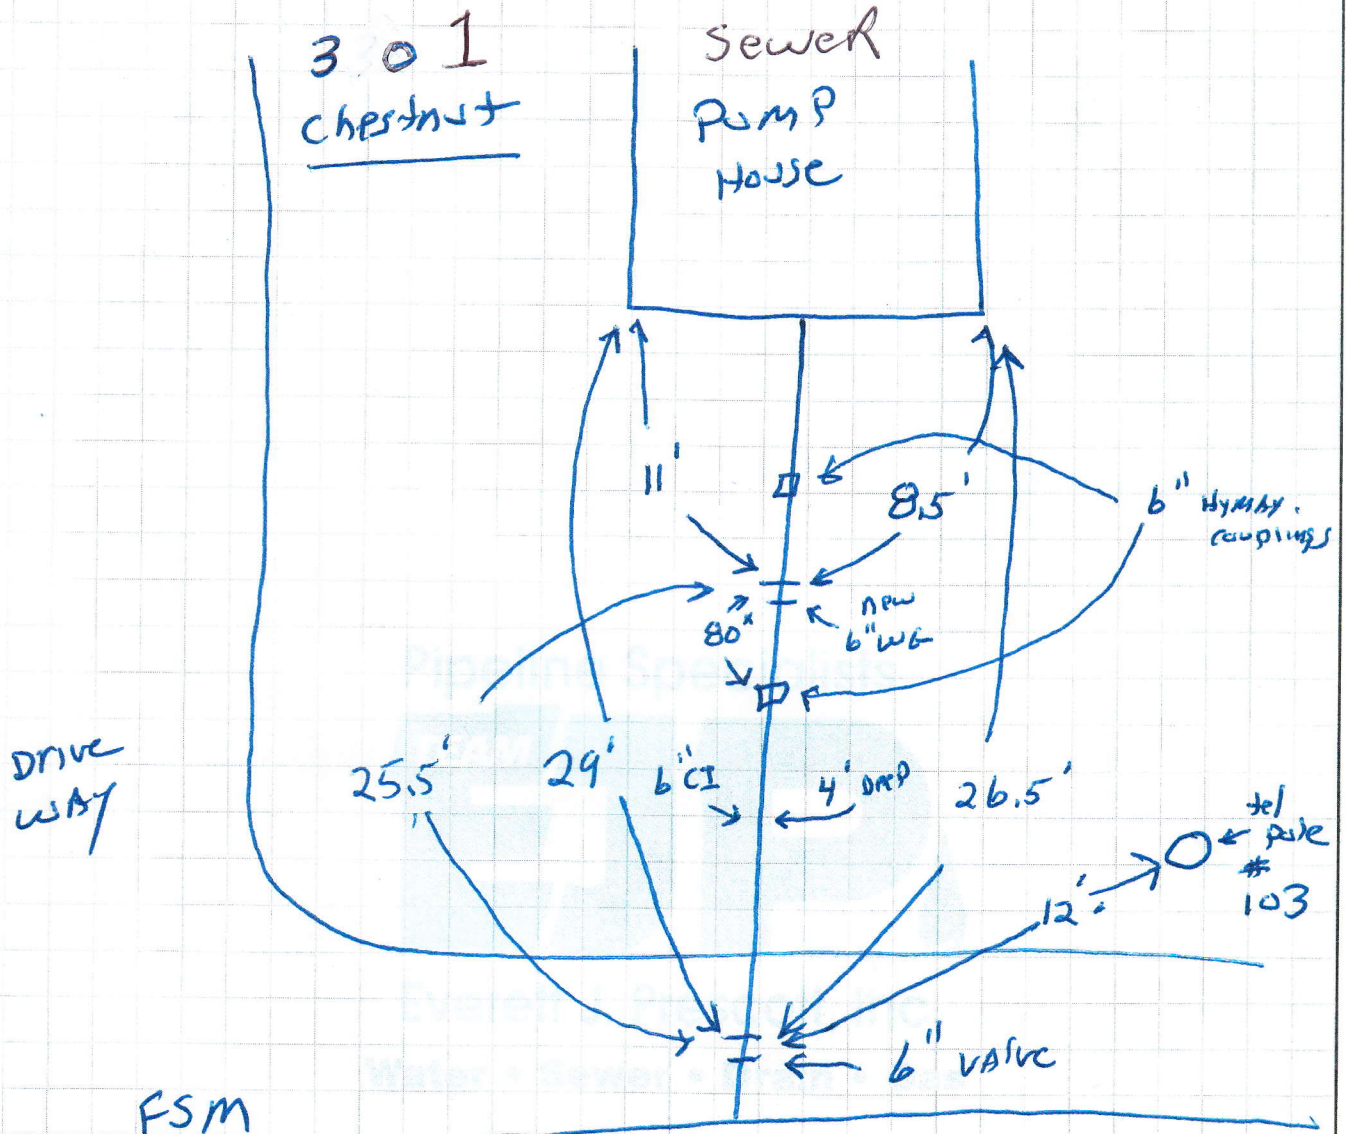

Chestnut Street