


25 Cooley AVE

12-2021

#25

1" CTSP
M-C
35'

Porch

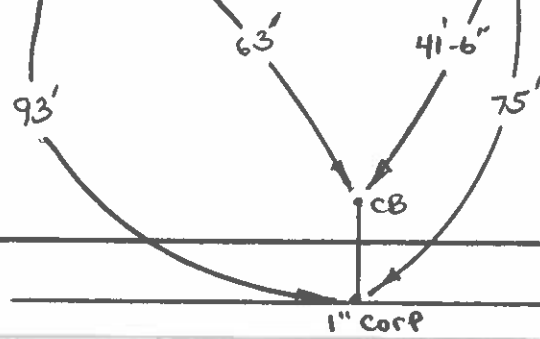

8" DI