


72 COOLEY AVE.

11-2021

Garage

#72

1" CTSP
M-C
23'-6"

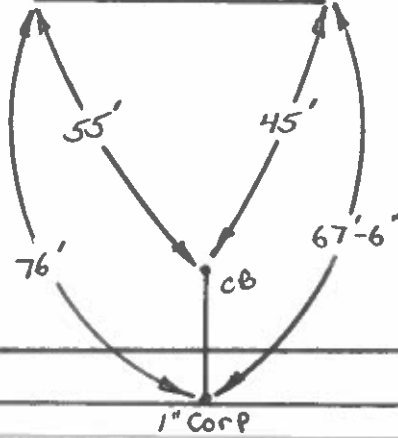

8' DI

1" Corp