


NO. STREET	DATE INST.	MAKE:	SIZE
136 DENSLOW RD.	5/21/04	BADGER	6" MAIN

House # 136

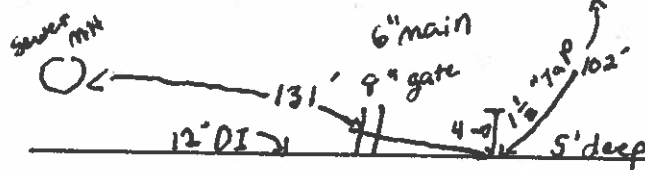

Denslow Rd