


42 EAST CIRCLE DRIVE

12-8-2021

Garage
←

#42

1" CTSP
m-c
24'

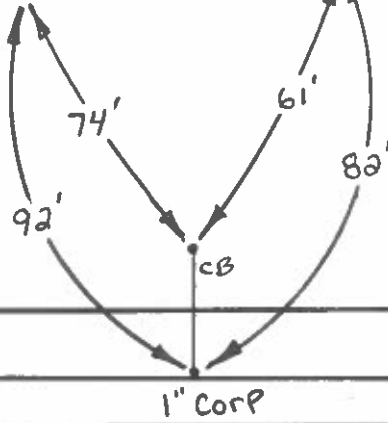

8" OI

1" Corp