


45 EAST CIRCLE DRIVE

12-6-2021

#45

Garage

1" CTSP
M-C
26'

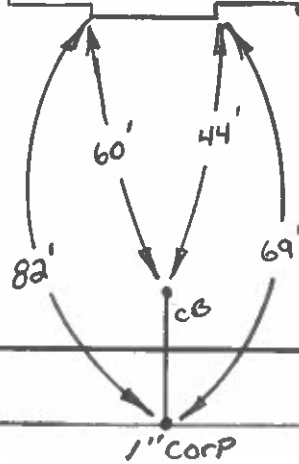

8" DI