


67 EAST CIRCLE DRIVE

12-9-2021

#67

1" CTSP
m-c
29'

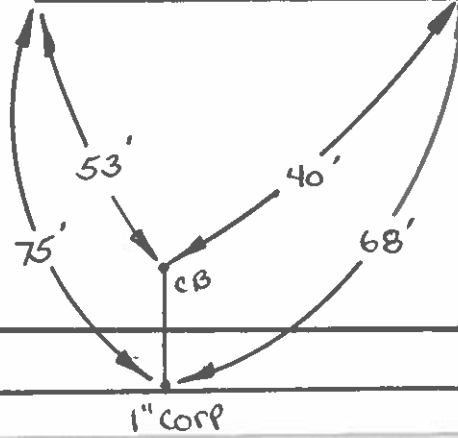

8" DI

1" Corp