


79 EAST CIRCLE DRIVE

12-13-2021

#79

chimney

1" c+sp
m-c
27'

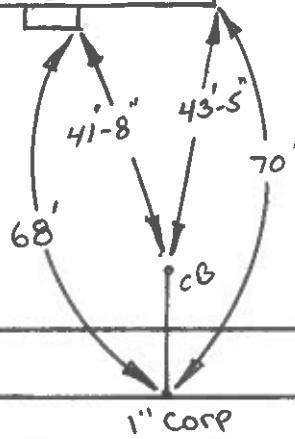

8" DI

1" corp