


99 EAST CIRCLE DRIVE

12-13-2021

#99

1" CTSP
m-c
31'-5"

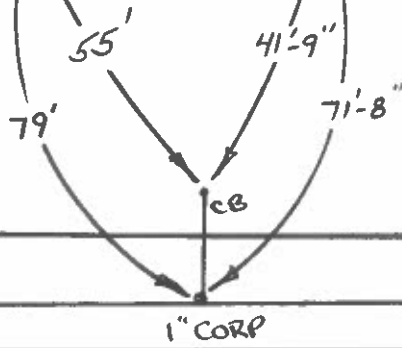

8" DI

1" CORP